

81 WATER WELL RECORD Form WWC-5


Division of Water Resources App. No.

Well ID OB-1-18

Original Record Correction Change in Well Use

1 LOCATION OF WATER WELL: County: Pottawatomie Fraction SW 1/4 SE 1/4 NW 1/4 SE 1/4 Section Number 32 Township Number T 9 S Range Number R 9 E W

2 WELL OWNER: Last Name: Pottawatomie Co. RWD #1 Business: 5650 N. Highway 99 Address: Wamego State: KS ZIP: 66547 Street or Rural Address where well is located (if unknown, distance and direction from nearest town or intersection): Approximately 2 miles north and 0.5 miles west of Saint George.

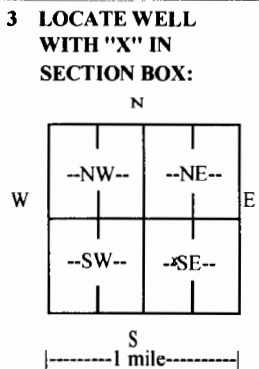

4 DEPTH OF COMPLETED WELL: 191 ft. Depth(s) Groundwater Encountered: 1) ft. 2) ft. 3) ft. or 4) Dry Well WELL'S STATIC WATER LEVEL: 111.12 ft. below land surface, measured on (mo-day-yr) 09-12-18 above land surface, measured on (mo-day-yr) Pump test data: Well water was not checked ft. after hours pumping gpm Well water was ft. after hours pumping gpm Estimated Yield: gpm Bore Hole Diameter: 5 in. to 193 ft. and in. to ft.

5 Latitude: 39.221868 (decimal degrees) Longitude: -96.432512 (decimal degrees) Horizontal Datum: WGS 84 NAD 83 NAD 27 Source for Latitude/Longitude: GPS (unit make/model: (WAAS enabled? Yes No) Land Survey Topographic Map Online Mapper: 6 Elevation: Unknown ft. Ground Level TOC Source: Land Survey GPS Topographic Map Other

7 WELL WATER TO BE USED AS: 1. Domestic: Household Lawn & Garden Livestock Irrigation Feedlot Industrial 2. Public Water Supply: well ID 3. Dewatering: how many wells? 4. Aquifer Recharge: well ID 5. Monitoring: well ID 6. Environmental Remediation: well ID Air Sparge Soil Vapor Extraction Recovery Injection 7. Oil Field Water Supply: lease 8. Test Hole: well ID Cased Uncased Geotechnical 9. Geothermal: how many bores? a) Closed Loop Horizontal Vertical b) Open Loop Surface Discharge Inj. of Water 10. Other (specify): Observation Well

Was a chemical/bacteriological sample submitted to KDHE? Yes No If yes, date sample was submitted: Water well disinfected? Yes No

8 TYPE OF CASING USED: Steel PVC CASING JOINTS: Glued Clamped Welded Threaded Other Casing diameter 2 in. to 149 ft., Diameter in. to ft., Diameter in. to ft. Casing height above land surface 24 in. Weight 0.73 lbs./ft. Wall thickness or gauge No. .154 TYPE OF SCREEN OR PERFORATION MATERIAL: Steel Stainless Steel Fiberglass PVC Other (Specify) Brass Galvanized Steel Concrete tile None used (open hole) SCREEN OR PERFORATION OPENINGS ARE: Continuous Slot Mill Slot Gauze Wrapped Torch Cut Drilled Holes Other (Specify) Louvered Shutter Key Punched Wire Wrapped Saw Cut None (Open Hole) SCREEN-PERFORATED INTERVALS: From 149 ft. to 189 ft., From ft. to ft., From ft. to ft. GRAVEL PACK INTERVALS: From 20 ft. to 193 ft., From ft. to ft., From ft. to ft.

9 GROUT MATERIAL: Neat cement Cement grout Bentonite Other Grout Intervals: From 0 ft. to 20 ft., From ft. to ft., From ft. to ft. Nearest source of possible contamination: Septic Tank Lateral Lines Pit Privy Livestock Pens Insecticide Storage Sewer Lines Cess Pool Sewage Lagoon Fuel Storage Abandoned Water Well Watertight Sewer Lines Seepage Pit Feedyard Fertilizer Storage Oil Well/Gas Well Other (Specify) None Known Direction from well? Distance from well? ft.

Table with columns: FROM, TO, LITHOLOGIC LOG, FROM, TO, LITHO. LOG (cont.) or PLUGGING INTERVALS. Rows include Topsoil, Clay, brown, Sand, very fine to medium, Sand, fine to coarse, tan, Clay, tan, sand streaks, Clay, gray, Blue gray, green, tan, clay, Clay, gray, green, Sand, fine to very fine.

11 CONTRACTOR'S OR LANDOWNER'S CERTIFICATION: This water well constructed, reconstructed, or plugged under my jurisdiction and was completed on (mo-day-year) 09-12-18 and this record is true to the best of my knowledge and belief. Kansas Water Well Contractor's License No. 185 This Water Well Record was completed on (mo-day-year) 09-17-18 under the business name of Clarke Well & Equipment, Inc. Signature