


1 LOCATION OF WATER WELL: Fraction SW 1/4 NW 1/4 SE 1/4 Section Number 31 Township Number T 7 S Range Number R 9 E
 County: POT

Distance and direction from nearest town or city street address of well if located within city? From St George 60 1/2 miles to Flush Rd. on Military Road west then go 1/4 mile north on Flush to School Creek & go 1/2 mile west

2 WATER WELL OWNER: Dirk Coit
 RR#, St. Address, Box #: 4460 Tupper Creek Blvd. #29
 Board of Agriculture, Division of Water Resources
 Application Number:

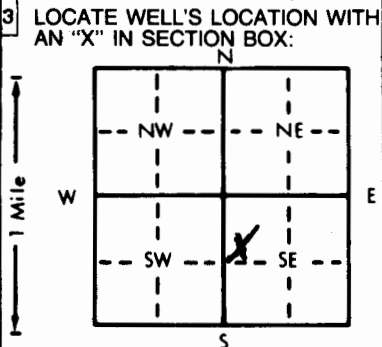

4 DEPTH OF COMPLETED WELL: 97 ft. ELEVATION:
 Depth(s) Groundwater Encountered 1. 72 ft. 2. ft. 3. ft.
 WELL'S STATIC WATER LEVEL 72 ft. below land surface measured on mo/day/yr
 Pump test data: Well water was ft. after hours pumping gpm
 Est. Yield 1.2 gpm: Well water was ft. after hours pumping gpm
 Bore Hole Diameter: 10 in. to 100 ft., and in. to ft.
 WELL WATER TO BE USED AS:
 1 Domestic (circled) 3 Feedlot 6 Oil field water supply 9 Dewatering 12 Other (Specify below)
 2 Irrigation 4 Industrial 7 Lawn and garden only 10 Monitoring well
 Was a chemical/bacteriological sample submitted to Department? Yes.....No.....; If yes, mo/day/yr sample was submitted
 Water Well Disinfected? Yes No

5 TYPE OF BLANK CASING USED:
 1 Steel (circled) 3 RMP (SR) 5 Wrought iron 8 Concrete tile CASING JOINTS: Glued (circled) Clamped
 2 PVC (circled) 4 ABS 6 Asbestos-Cement 9 Other (specify below) Welded
 7 Fiberglass Threaded
 Blank casing diameter 5 in. to 7.7 ft., Dia in. to ft., Dia in. to ft.
 Casing height above land surface 2 in., weight SDR 26 lbs./ft. Wall thickness or gauge No.
 TYPE OF SCREEN OR PERFORATION MATERIAL:
 1 Steel 3 Stainless steel 5 Fiberglass 7 PVC (circled) 10 Asbestos-cement
 2 Brass 4 Galvanized steel 6 Concrete tile 8 RMP (SR) 11 Other (specify)
 9 ABS 12 None used (open hole)
 SCREEN OR PERFORATION OPENINGS ARE: 10/1000's
 1 Continuous slot 3 Mill slot (circled) 5 Gauzed wrapped 8 Saw cut 11 None (open hole)
 2 Louvered shutter 4 Key punched 6 Wire wrapped 9 Drilled holes
 7 Torch cut 10 Other (specify)
 SCREEN-PERFORATED INTERVALS: From 7.7 ft. to 97 ft., From ft. to ft.
 From ft. to ft., From ft. to ft.
 GRAVEL PACK INTERVALS: From 25 ft. to 97 ft., From ft. to ft.
 From ft. to ft., From ft. to ft.

6 GROUT MATERIAL: 1 Neat cement 2 Cement grout 3 Bentonite (circled) 4 Other
 Grout intervals: From 0 ft. to 25 ft., From ft. to ft., From ft. to ft.
 What is the nearest source of possible contamination: None
 1 Septic tank (circled) 4 Lateral lines (circled) 7 Pit privy
 2 Sewer lines 5 Cess pool 8 Sewage lagoon
 3 Watertight sewer lines 6 Seepage pit 9 Feedyard
 10 Livestock pens 14 Abandoned water well
 11 Fuel storage 15 Oil well/Gas well
 12 Fertilizer storage 16 Other (specify below)
 13 Insecticide storage
 Direction from well? N.W.
 How many feet? 130'

FROM	TO	LITHOLOGIC LOG	FROM	TO	PLUGGING INTERVALS
0	2	Top Soil			
2	55	Brown Sandy Clay			
55	72	Greenish clay			
72	95	Fine sand (WATER)			
95	100	Grey shale			

7 CONTRACTOR'S OR LANDOWNER'S CERTIFICATION: This water well was (1) constructed, (2) reconstructed, or (3) plugged under my jurisdiction and was completed on (mo/day/year) 7/25/94 and this record is true to the best of my knowledge and belief. Kansas Water Well Contractor's License No. 451 This Water Well Record was completed on (mo/day/yr) 8/29/94 under the business name of Haldeman Well Drilling by (signature) Greg H. CWOPI