


1	LOCATION OF WATER WELL:	Fraction	Section Number	Township Number	Range Number
	County: <u>OTTAWA</u>	<u>NE 1/4 NE 1/4 NW 1/4</u>	<u>24</u>	<u>10</u>	<u>1W</u>

Distance and direction from nearest town or city street address of well if located within city?
2948 OXBOW RD

2 WATER WELL OWNER: MRS. HAUSEMAN
 RR #, St. Address, Box #: 2948 OXBOW RD.
 City, State, ZIP Code : LONGFORD, KS 67458
 Board of Agriculture, Division of Water Resources
 Application Number: _____

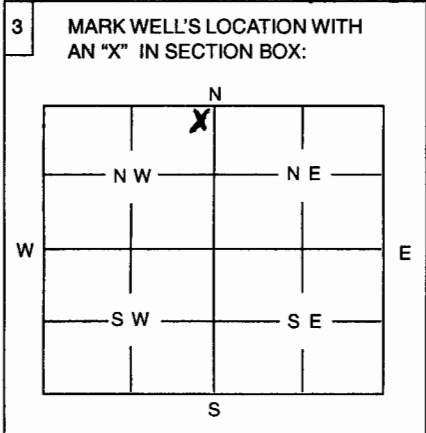

4 DEPTH OF WELL 79 ft
 WELL'S STATIC WATER LEVEL 55 ft.
 WELL WAS USED AS:

<u>1 Domestic</u>	5 Public Water Supply	9 Dewatering
2 Irrigation	6 Oil Field Water Supply	10 Monitoring Well
3 Feedlot	7 Domestic (Lawn & Garden)	11 Injection Well
4 Industrial	8 Air Conditioning	12 Other

 Was a chemical / bacteriological sample submitted to Department? Yes No X
 If yes, mo/day/yr sample was submitted

5 TYPE OF BLANK CASING USED:
 1 Steel 3 RMP (SR) 5 Wrought 7 Fiberglass 9 Other (Specify below)
 2 PVC 4 ABS 6 Asbestos-Cement 8 Concrete Tile

Blank casing diameter 5 in. Was casing pulled? Yes X No If yes, how much 5'
 Casing height above or below land surface 60 in.

6 GROUT PLUG MATERIAL: 1 Neat cement 2 Cement grout 3 Bentonite 4 Other

Grout Plug Intervals: From 5 ft. to 79 ft., From ft. to ft., From to ft.

What is the nearest source of possible contamination:

<u>1 Septic tank</u>	6 Seepage pit	11 Fuel storage	16 Other (specify below)
2 Sewer lines	7 Pit privy	12 Fertilizer storage
3 Watertight sewer lines	8 Sewage lagoon	13 Insecticide storage
4 Lateral lines	9 Feedyard	14 Abandoned water well
5 Cess Pool	10 Livestock pens	15 Oil well/Gas well

 Direction from well? NORTH How many feet? 25

FROM	TO	PLUGGING MATERIALS
<u>0</u>	<u>5</u>	<u>FILL DIRT</u>
<u>5</u>	<u>79</u>	<u>BENTONITE HOLEPLUG</u>

7 CONTRACTOR'S OR LANDOWNER'S CERTIFICATION: This water well was plugged under my jurisdiction and was completed on (mo/day/year) 05-15-08 and this record is true to the best of my knowledge and belief. Kansas Water Well Contractor's License No. 388 This Water Well Record was completed on (mo/day/year) 05-15-08 under the business name of PESTICIDE PUMP SERVICE by (signature) Paul Redigo

INSTRUCTIONS: Use typewriter or ball point pen. Please press firmly and print clearly. Please fill in blanks, underline or circle the correct answers. Send top three copies to Kansas Department of Health and Environment, Bureau of Water, Topeka, Kansas 66620-0001. Telephone: 785/296-3565. Send one to Water Well Owner and retain one for your records.