


1 LOCATION OF WATER WELL: Fraction NE 1/4 NE 1/4 NE 1/4 Section Number 1 Township Number T 10 S Range Number R 1  
 County: Ottawa

Distance and direction from nearest town or city street address of well if located within city?  
6 miles north of Minneapolis, KS

2 WATER WELL OWNER: Delphos Coopertive Assn.  
 RR#, St. Address, Box #: P.O. Box 346 Board of Agriculture, Division of Water Resources  
 City, State, ZIP Code: Delphos, KS 67436 Application Number:

3 LOCATE WELL'S LOCATION WITH AN "X" IN SECTION BOX:

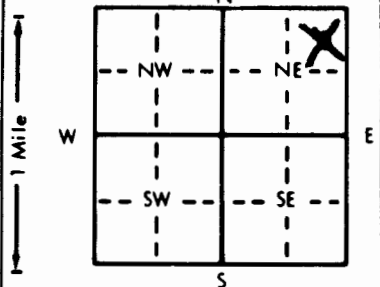

4 DEPTH OF COMPLETED WELL: 135 ft. ELEVATION:  
 Depth(s) Groundwater Encountered 1. 60 ft. 2. ft. 3. ft.  
 WELL'S STATIC WATER LEVEL: 60 ft. below land surface measured on mo/day/yr 6-22-93  
 Pump test data: Well water was ft. after hours pumping gpm  
 Est. Yield: 65 gpm: Well water was 65 ft. after 1 hours pumping 1.0 gpm  
 Bore Hole Diameter: 8 in. to 19.2 ft., and in. to ft.  
 WELL WATER TO BE USED AS:  
 5 Public water supply 8 Air conditioning 11 Injection well  
1 Domestic 3 Feedlot 6 Oil field water supply 9 Dewatering 12 Other (Specify below)  
 2 Irrigation 4 Industrial 7 Lawn and garden only 10 Monitoring well  
 Was a chemical/bacteriological sample submitted to Department? Yes.....No. X.....; If yes, mo/day/yr sample was submitted  
 Water Well Disinfected? Yes X No

5 TYPE OF BLANK CASING USED:  
 1 Steel 3 RMP (SR) 5 Wrought iron 8 Concrete tile CASING JOINTS: Glued X Clamped  
 2 PVC 4 ABS 6 Asbestos-Cement 9 Other (specify below) Welded  
 7 Fiberglass Threaded

Blank casing diameter: 5 in. to 11.5 ft., Dia. in. to ft., Dia. in. to ft.  
 Casing height above land surface: 1.2 in., weight: 2.37 lbs./ft. Wall thickness or gauge No. 214

TYPE OF SCREEN OR PERFORATION MATERIAL:  
 1 Steel 3 Stainless steel 5 Fiberglass 7 PVC 10 Asbestos-cement  
 2 Brass 4 Galvanized steel 6 Concrete tile 8 RMP (SR) 11 Other (specify)  
 12 None used (open hole)

SCREEN OR PERFORATION OPENINGS ARE:  
 1 Continuous slot 3 Mill slot 5 Gauzed wrapped 8 Saw cut 11 None (open hole)  
 2 Louvered shutter 4 Key punched 6 Wire wrapped 9 Drilled holes  
 7 Torch cut 10 Other (specify)

SCREEN-PERFORATED INTERVALS: From 1.15 ft. to 135 ft., From ft. to ft.  
 From ft. to ft., From ft. to ft.  
 GRAVEL PACK INTERVALS: From 25 ft. to 135 ft., From ft. to ft.  
 From ft. to ft., From ft. to ft.

6 GROUT MATERIAL: 1 Neat cement 2 Cement grout 3 Bentonite 4 Other  
 Grout Intervals: From 5 ft. to 25 ft., From ft. to ft., From ft. to ft.

What is the nearest source of possible contamination:  
 1 Septic tank 4 Lateral lines 7 Pit privy 10 Livestock pens 14 Abandoned water well  
 2 Sewer lines 5 Cess pool 8 Sewage lagoon 11 Fuel storage 15 Oil well/Gas well  
 3 Watertight sewer lines 6 Seepage pit 9 Feedyard 12 Fertilizer storage 16 Other (specify below)  
 13 Insecticide storage

Direction from well? South How many feet? 100 ft

FROM	TO	LITHOLOGIC LOG	FROM	TO	PLUGGING INTERVALS
0	2	Top Soil			
2	5	Dark Gray Clay			
5	17	Light Gray Clay			
17	41	Fine Sandy Clay			
41	51	Fine Sand			
51	53	Tan Shale			
53	62	Gray Shale			
62	63	Limestone			
63	96	Gray Shale			
96	173	SANDstone			
173	177	Gray Shale			
177	192	Sandstone			

7 CONTRACTOR'S OR LANDOWNER'S CERTIFICATION: This water well was (1) constructed, (2) reconstructed, or (3) plugged under my jurisdiction and was completed on (mo/day/year) 6-22-93 and this record is true to the best of my knowledge and belief. Kansas Water Well Contractor's License No. 1.38 This Water Well Record was completed on (mo/day/yr) 6-22-93 under the business name of Peterson Irrigation Inc. by (signature) Mike Peterson