


**1 LOCATION OF WATER WELL:** Fraction NW 1/4 NW 1/4 SW 1/4 Section Number 00 Township Number 10 Range Number 12 E  
 County: Osborne  
 Distance and direction from nearest town or city street address of well if located within city?  
Lurray, KS north on 281 3/4 on east side of Road

**2 WATER WELL OWNER:** Tes McKnight **Global Positioning Systems** (decimal degrees, min. of 4 digits)  
 RR#, St. Address, Box #: 2807 South US Hwy 281 Latitude: \_\_\_\_\_  
 City, State ZIP Code: Lurray, KS 67649 Longitude: \_\_\_\_\_  
 Elevation: \_\_\_\_\_  
 Datum: \_\_\_\_\_  
 Data Collection Method: \_\_\_\_\_

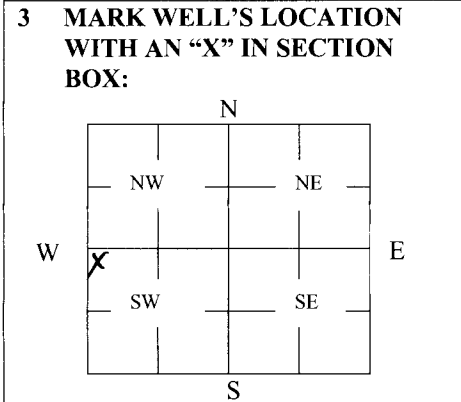

**4 DEPTH OF WELL** 16 ft.  
 WELL'S STATIC WATER LEVEL 14 ft.  
 WELL WAS USED AS:  
 Domestic      5 Public Water Supply      9 Dewatering  
 2 Irrigation      6 Oil Field Water Supply      10 Monitoring  
 3 Feedlot      7 Domestic (Lawn & Garden)      11 Injection Well  
 4 Industrial      8 Air Conditioning      12 Other \_\_\_\_\_  
 Was a chemical/bacteriological sample submitted to Department? Yes \_\_\_\_\_ No

**5 TYPE OF BLANK CASING USED:**  
 Steel      3 RMP (SR)      5 Wrought      7 Fiberglass      9 Other (Specify below) \_\_\_\_\_  
 2 PVC      4 ABS      6 Asbestos-Cement      8 Concrete Tile \_\_\_\_\_  
 Blank casing diameter 1 1/4 in. Was casing pulled? Yes  No \_\_\_\_\_ If yes, how much 16 ft  
 Casing height above or below land surface \_\_\_\_\_ in.

**6 GROUT PLUG MATERIAL:** 1 Neat cement      2 Cement grout       Bentonite      4 Other \_\_\_\_\_  
 Grout Plug Intervals: From 5 ft. to 3 ft., From \_\_\_\_\_ ft. to \_\_\_\_\_ ft., From \_\_\_\_\_ to \_\_\_\_\_ ft.  
 What is the nearest source of possible contamination:  
 1 Septic tank      6 Seepage pit      11 Fuel Storage      16 Other (specify below) none  
 2 Sewer lines      7 Pit privy      12 Fertilizer storage  
 3 Watertight sewer lines      8 Sewage lagoon      13 Insecticide storage  
 4 Lateral lines      9 Feedyard      14 Abandoned water well      Direction from well? \_\_\_\_\_  
 5 Cess pool      10 Livestock pens      15 Oil well/Gas well      How many feet? \_\_\_\_\_

FROM	TO	PLUGGING MATERIALS	FROM	TO	PLUGGING MATERIALS
<u>14</u>	<u>14</u>	<u>Crinoidal sand</u>			
<u>14</u>	<u>5</u>	<u>Natural clays</u>			
<u>5</u>	<u>3</u>	<u>Bentonite Plug</u>			
<u>3</u>	<u>0</u>	<u>TOPSOIL</u>			

**7 CONTRACTOR'S OR LANDOWNER'S CERTIFICATION:** This water well was plugged under my jurisdiction and was completed on (mo/day/year) 11-24-14 and this record is true to the best of my knowledge and belief. Kansas Water Well Contractor's License No. 776. This Water Well Record was completed on (mo/day/year) 12-1-14 under the business name of Rainy Water Well by (signature) Jerry Rainey

**INSTRUCTIONS:** Use typewriter or ballpoint pen. Please press firmly and print clearly. Please fill in blanks, underline or circle the correct answers. Send top three copies to Kansas Department of Health and Environment, Bureau of Water, Geology Section, 1000 SW Jackson St., Ste. 420, Topeka, Kansas 66612-1367. Telephone: 785/296-5522. Send one to Water Well Owner and retain one for your records. Visit us at <http://www.kdheks.gov/geo/waterwells>.