


1 LOCATION OF WATER WELL: County: <u>Osborne</u>	Fraction <u>SW 1/4 NE 1/4 SE 1/4</u>	Section Number <u>8</u>	Township Number <u>T 10 S</u>	Range Number <u>R 14 EW</u>
---	---	----------------------------	----------------------------------	--------------------------------

Distance and direction from nearest town or city street address of well if located within city?

Approximately 6 1/2 miles east of Natoma

2 WATER WELL OWNER: RR#, St. Address, Box # : City, State, ZIP Code :	<u>Meyer Land & Cattle</u> <u>c/o Chris Meyer</u> <u>Box 149</u> <u>Sylvan Grove, KS 67481</u>	Board of Agriculture, Division of Water Resources Application Number:
---	---	--

3 LOCATE WELL'S LOCATION WITH AN "X" IN SECTION BOX:	4 DEPTH OF COMPLETED WELL..... <u>38</u> ft. ELEVATION: .. <u>unknown</u>
--	---

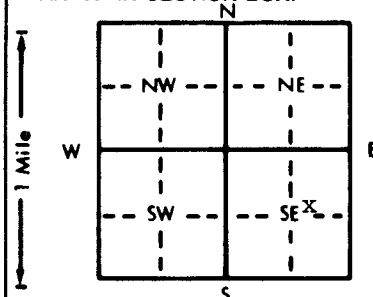

Depth(s) Groundwater Encountered 1..... ft. 2..... ft. 3..... ft.
 WELL'S STATIC WATER LEVEL .. 20 ft. below land surface measured on mo/day/yr .. 1-20-92

Pump test data: Well water was not ch'd ft. after hours pumping gpm
 Est. Yield unknown gpm: Well water was ft. after hours pumping gpm
 Bore Hole Diameter... 9 in. to 35 ft., and in. to ft.

WELL WATER TO BE USED AS: 5 Public water supply 8 Air conditioning 11 Injection well
 1 Domestic 3 Feedlot 6 Oil field water supply 9 Dewatering 12 Other (Specify below)
 2 Irrigation 4 Industrial 7 Lawn and garden only 10 Monitoring well Stock

Was a chemical/bacteriological sample submitted to Department? Yes.....No.....X.....; If yes, mo/day/yr sample was submitted
 Water Well Disinfected? Yes No X

5 TYPE OF BLANK CASING USED:	5 Wrought iron	8 Concrete tile	CASING JOINTS: Glued Clamped
------------------------------	----------------	-----------------	--

Blank casing diameter 5 in. to 25 ft., Dia in. to ft., Dia in. to ft.
 Casing height above land surface 36 in., weight 2.36 lbs./ft. Wall thickness or gauge No. 214

TYPE OF SCREEN OR PERFORATION MATERIAL:	7 PVC	10 Asbestos-cement
---	-------	--------------------

SCREEN OR PERFORATION OPENINGS ARE:	5 Gauzed wrapped	8 Saw cut	11 None (open hole)
-------------------------------------	------------------	-----------	---------------------

SCREEN-PERFORATED INTERVALS:	From <u>25</u> ft. to <u>35</u> ft., From ft. to ft.
------------------------------	--

GRAVEL PACK INTERVALS:	From <u>20</u> ft. to <u>35</u> ft., From ft. to ft.
------------------------	--

6 GROUT MATERIAL:	1 Neat cement	2 Cement grout	3 Bentonite	4 Other .. <u>Bentonite Holeplug</u>
-------------------	---------------	----------------	-------------	--

Grout Intervals: From ft. to ft., From ft. to ft., From 0 ft. to 20 ft.

What is the nearest source of possible contamination:

1 Septic tank	4 Lateral lines	7 Pit privy	10 Livestock pens	14 Abandoned water well
2 Sewer lines	5 Cess pool	8 Sewage lagoon	11 Fuel storage	15 Oil well/Gas well
3 Watertight sewer lines	6 Seepage pit	9 Feedyard	12 Fertilizer storage	16 Other (specify below)
			13 Insecticide storage	<u>None known</u>

Direction from well? How many feet?

FROM	TO	LITHOLOGIC LOG	FROM	TO	PLUGGING INTERVALS
0	12	Topsoil, clay			
12	24	Clay, tan mixed with rock, white			
24	35	Clay mixed with gravel, coarse, white			

7 CONTRACTOR'S OR LANDOWNER'S CERTIFICATION: This water well was (1) <u>constructed</u> , (2) reconstructed, or (3) plugged under my jurisdiction and was completed on (mo/day/year) <u>1-20-92</u> and this record is true to the best of my knowledge and belief. Kansas Water Well Contractor's License No. <u>185</u> This Water Well Record was completed on (mo/day/yr) <u>2-19-92</u> under the business name of <u>Clarke Well & Equipment, Inc.</u> by (signature) <u>Clarke Well & Equipment</u>
