


1 LOCATION OF WATER WELL: County: Oswage Fraction: NE 1/4 NE 1/4 NE 1/4 Section Number: 17 Township Number: T 10 S Range Number: R 15 E/W

Distance and direction from nearest town or city street address of well if located within city?

1/2 mile East of Notoma Kansas

2 WATER WELL OWNER: Burgie Ruggels Board of Agriculture, Division of Water Resources
 RR#, St. Address, Box #: Notoma Kansas 69651 Application Number:

3 LOCATE WELL'S LOCATION WITH AN "X" IN SECTION BOX:

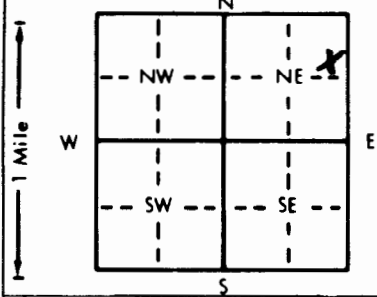

4 DEPTH OF COMPLETED WELL: 5.0 ft. ELEVATION:

Depth(s) Groundwater Encountered 1. 3.5 ft. 2. ft. 3. ft.

WELL'S STATIC WATER LEVEL: 35 ft. below land surface measured on mo/day/yr 3-26-92

Pump test data: Well water was ft. after hours pumping gpm
 Est. Yield 10 gpm: Well water was ft. after hours pumping gpm

Bore Hole Diameter: 10 in. to 5.0 ft., and in. to ft.

WELL WATER TO BE USED AS: 5 Public water supply 8 Air conditioning 11 Injection well
 ① Domestic 3 Feedlot 6 Oil field water supply 9 Dewatering 12 Other (Specify below)
 2 Irrigation 4 Industrial 7 Lawn and garden only 10 Monitoring well

Was a chemical/bacteriological sample submitted to Department? Yes.....No..... If yes, mo/day/yr sample was submitted

5 TYPE OF BLANK CASING USED: 5 Wrought iron 8 Concrete tile CASING JOINTS: Glued Clamped.....
 1 Steel 3 RMP (SR) 6 Asbestos-Cement 9 Other (specify below) Welded.....
 ② PVC 4 ABS 7 Fiberglass Threaded.....

Blank casing diameter: 5 in. to 36 ft., Dia. in. to ft., Dia. in. to ft.

Casing height above land surface: 20 in., weight 160 lbs./ft. Wall thickness or gauge No.

TYPE OF SCREEN OR PERFORATION MATERIAL: ⑦ PVC 10 Asbestos-cement
 1 Steel 3 Stainless steel 5 Fiberglass 8 RMP (SR) 11 Other (specify).....
 2 Brass 4 Galvanized steel 6 Concrete tile 9 ABS 12 None used (open hole)

SCREEN OR PERFORATION OPENINGS ARE: 5 Gauzed wrapped ⑧ Saw cut 11 None (open hole)
 1 Continuous slot 3 Mill slot 6 Wire wrapped 9 Drilled holes
 2 Louvered shutter 4 Key punched 7 Torch cut 10 Other (specify).....

SCREEN-PERFORATED INTERVALS: From 36 ft. to 50 ft., From ft. to ft.
 From ft. to ft., From ft. to ft.

GRAVEL PACK INTERVALS: From 30 ft. to 50 ft., From ft. to ft.
 From ft. to ft., From ft. to ft.

6 GROUT MATERIAL: 1 Neat cement 2 Cement grout ③ Bentonite 4 Other.....

Grout intervals: From 0 ft. to 25 ft., From ft. to ft., From ft. to ft.

What is the nearest source of possible contamination: 10 Livestock pens 14 Abandoned water well
 1 Septic tank 4 Lateral lines 7 Pit privy 11 Fuel storage 15 Oil well/Gas well
 2 Sewer lines 5 Cess pool 8 Sewage lagoon 12 Fertilizer storage 16 Other (specify below)
 3 Watertight sewer lines 6 Seepage pit 9 Feedyard 13 Insecticide storage

Direction from well? How many feet?

FROM	TO	LITHOLOGIC LOG	FROM	TO	PLUGGING INTERVALS
0	12	Surface Clay			
12	18	Fine sandy Clay			
18	30	Fine sand			
30	38	yellow Clay			
38	45	med sand			
45	50	Blue shale			

7 CONTRACTOR'S OR LANDOWNER'S CERTIFICATION: This water well was (1) constructed, (2) reconstructed, or (3) plugged under my jurisdiction and was completed on (mo/day/year) 3-26-92 and this record is true to the best of my knowledge and belief. Kansas Water Well Contractor's License No. 444 This Water Well Record was completed on (mo/day/yr) 3-26-92 under the business name of Indium Drilling by (signature) Prof Indium