USE TYPEWRITER OR BALL POINT PEN-PRESS FIRMLY, PRINT CLEARLY.

WATER WELL RECORD
KSA 82a-1201-1215

Kansas Department of Health and Environment-Division of Environment
(Water well Contractors)
Topeka, Kansas 66620

1. Location of well:	County	Fraction	Section number	Township number	Range number
	Osborne	N.W 1/4 NW 1/4 Se 1/4	22	T 10 S S	R 15 E/W

2. Distance and direction from nearest town or city: 3 miles S.E. of Natoma
Street address of well location if in city:

3. Owner of well:
R.R. or street: Lawrence Koelling
City, state, zip code: Paradise, Kansas 67658

4. Locate with "X" in section below: Sketch map:

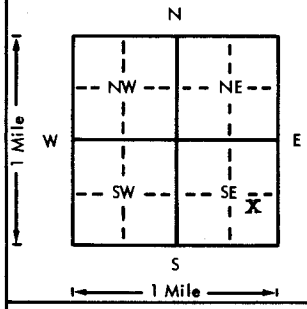

Well is about 200' East of dwelling

5. Type and color of material	From	To
Top soil black	0	10
White rock oand yellow clay	10	30
White water gravel and rock	30	45
Black shale	45	48

(Use a second sheet if needed)

6. Bore hole dia. 11 in. Completion date 4/10-78
Well depth 48 ft.

7. __ Cable tool x Rotary __ Driven __ Dug
__ Hollow rod __ Jetted __ Bored __ Reverse rotary

8. Use: __ Domestic __ Public supply __ Industry
__ Irrigation __ Air conditioning x Stock
__ Lawn __ Oil field water __ Other

9. Casing: Material PVC Height: Above or ~~Below~~
Threaded __ Welded x Surface 24 in.
RMP __ PVC 6" Weight 2 lbs./ft.
Dia. 6 in. to 48 ft. depth Wall Thickness: inches or
Dia. __ in. to __ ft. depth gage No. 250

10. Screen: Manufacturer's name
Type 1/8" slots Dia. 6"
Slot/gauze Length 10'
Set between 23 ft. and 43 ft.
ft. and ft.
Gravel pack? yes Size range of material CMA ± to 1/8"

11. Static water level: mo./day/yr.
19 ft. below land surface Date 4/10

12. Pumping level below land surfaces:
19 ft. after 3 hrs. pumping 18 g.p.m.
19 ft. after 4 hrs. pumping 18 g.p.m.
Estimated maximum yield 40 g.p.m.

13. Water sample submitted: mo./day/yr.
__ Yes x No Date

14. Well head completion:
x Pitless adapter ____ Inches above grade

15. Well grouted? yes
With: x Neat cement __ Bentonite __ Concrete
Depth: From 14 ft. to 4 ft.

16. Nearest source of possible contamination:
ft. 50 Direction ~~South~~ Type ~~correl~~
Well disinfected upon completion? x Yes __ No

17. Pump: x Not installed
Manufacturer's name
Model number HP Volts
Length of drop pipe ft. capacity g.p.m.
Type:
__ Submersible __ Turbine
__ Jet __ Reciprocating
__ Centrifugal __ Other

18. Elevation:
Topography:
__ Hill
__ Slope
__ Upland
x Valley

19. Remarks:
Well is on level ground about 50' from cattle corral

Owner agrees to run burv

20. Water well contractor's certification:
This well was drilled under my jurisdiction and this report is true to the best of my knowledge and belief.
Rush Water Well Service 310
Business name License No.
Address Natoma, Kansas 67651
Signed Oscar Rush Date 5/5/78
Authorized representative

T 10 R 15 E(W) Sec 22 1/4 1/4 1/4 NWNWSE

Forward the white, blue and pink copies to the Department of Health and Environment

Form WWC-5

MI-1023