


1 LOCATION OF WATER WELL: County: Rooks Fraction: SE 1/4 SE 1/4 NE 1/4 Section Number: 9 Township Number: T 10 S Range Number: R 16 EW

Distance and direction from nearest town or city street address of well if located within city? Approx. 5 miles West of Natoma, Ks - Frontyard (2780 Hwy 18, Rooks Co., Kansas)

2 WATER WELL OWNER: Leo Zeigler
 RR#, St. Address, Box #: 2780 Hwy 18
 City, State, ZIP Code: Natoma, Kansas 67651
 Board of Agriculture, Division of Water Resources
 Application Number:

3 LOCATE WELL'S LOCATION WITH AN "X" IN SECTION BOX: 4 DEPTH OF COMPLETED WELL: 40 ft. ELEVATION: NA

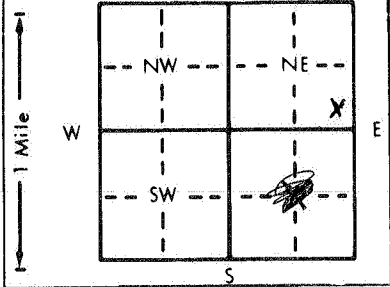

Depth(s) Groundwater Encountered 1. 10 ft. 2. 20 ft. 3. _____ ft.
 WELL'S STATIC WATER LEVEL 26 ft. below land surface measured on 6-17-96
 Pump test data: Well water was NA ft. after _____ hours pumping _____ gpm
 Est. Yield 7 gpm Well water was _____ ft. after _____ hours pumping _____ gpm
 Bore Hole Diameter 9 in. to 40 ft., and _____ in. to _____ ft.
 WELL WATER TO BE USED AS:
 1 Domestic 3 Feedlot 6 Oil field water supply 9 Dewatering 12 Other (Specify below)
 2 Irrigation 4 Industrial 7 Lawn and garden only 10 Monitoring well
 Was a chemical/bacteriological sample submitted to Department? Yes _____ No If yes, mo/day/yr sample was submitted _____
 Water Well Disinfected? Yes No _____

5 TYPE OF BLANK CASING USED:
 1 Steel 3 RMP (SR) 5 Wrought iron 8 Concrete tile CASING JOINTS: Glued _____ Clamped _____
 2 PVC 4 ABS 7 Fiberglass 9 Other (specify below) splined Certa-lok Welded _____
 Blank casing diameter 5 in. to 20 ft. Dia _____ in. to _____ ft. Dia _____ in. to _____ ft.
 Casing height above land surface 18" in., weight _____ lbs./ft. Wall thickness or gauge No. SAR 21

TYPE OF SCREEN OR PERFORATION MATERIAL:
 1 Steel 3 Stainless steel 5 Fiberglass 8 RMP (SR) 10 Asbestos-cement
 2 Brass 4 Galvanized steel 6 Concrete tile 9 ABS 11 Other (specify) _____
 12 None used (open hole)

SCREEN OR PERFORATION OPENINGS ARE:
 1 Continuous slot 3 Mill slot 5 Gauzed wrapped 8 Saw cut 11 None (open hole)
 2 Louvered shutter 4 Key punched 6 Wire wrapped 9 Drilled holes
 7 Torch cut 10 Other (specify) _____

SCREEN-PERFORATED INTERVALS: From 20 ft. to 40 ft., From _____ ft. to _____ ft.
 From _____ ft. to _____ ft., From _____ ft. to _____ ft.
 GRAVEL PACK INTERVALS: From 7.0 ft. to 40 ft., From 19 ft. to _____ ft.
 From _____ ft. to _____ ft., From _____ ft. to _____ ft.

6 GROUT MATERIAL: 1 Neat cement 2 Cement grout 3 Bentonite 4 Other _____
 Grout Intervals: From 3 ft. to 14 ft., From 19 ft. to surface ft., From _____ ft. to _____ ft.

What is the nearest source of possible contamination:
 1 Septic tank 4 Lateral lines 7 Pit privy 10 Livestock pens 14 Abandoned water well
 2 Sewer lines 5 Cess pool 8 Sewage lagoon 11 Fuel storage 15 Oil well/Gas well
 3 Watertight sewer lines 6 Seepage pit 9 Feedyard 12 Fertilizer storage 16 Other (specify below)
 13 Insecticide storage
 Direction from well? #10' East How many feet? 110'

FROM	TO	LITHOLOGIC LOG	FROM	TO	PLUGGING INTERVALS
0	5	loess			
5	7	dark brn. clay			
7	10	heavy soil w/ sd. lens			
10	20	clay w/ scattered sd. shows			
20	30	brown clay w/ intermitten			
30	40	sandy and white lms. lens. blue gray weathered shale			

7 CONTRACTOR'S OR LANDOWNER'S CERTIFICATION: This water well was constructed, reconstructed, or plugged under my jurisdiction and was completed on (mo/day/year) 6-17-96 and this record is true to the best of my knowledge and belief. Kansas Water Well Contractor's License No. 608 This Water Well Record was completed on (mo/day/yr) 6-29-96 under the business name of Yellow Jacket Drilling by (signature) Ernest W. Bradshill