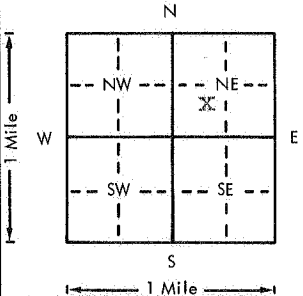


USE TYPEWRITER OR BALL POINT PEN-PRESS FIRMLY, PRINT CLEARLY.

WATER WELL RECORD
KSA 82a-1201-1215

Kansas Department of Health and Environment-Division of Environment
(Water well Contractors)
Topeka, Kansas 66620

1. Location of well:	County Rooks	Fraction N E/4 SW 1/4 NE 1/4	Section number 8	Township number T 10 S	Range number S R 16 W E/W
2. Distance and direction from nearest town or city: Street address of well location if in city: About 4 1/2 miles West of Natoma			3. Owner of well: Elmer Dougherty Estate R.R. or street: Lee Drappe 67202 City, state, zip code: 800 4th -Wichita Kansas		
4. Locate with "X" in section below: Sketch map: 			6. Bore hole dia. 7 1/2 in. Completion date 4-29-78 Well depth 41 ft.		
5. Type and color of material			7. <input type="checkbox"/> Cable tool <input checked="" type="checkbox"/> Rotary <input type="checkbox"/> Driven <input type="checkbox"/> Dug <input type="checkbox"/> Hollow rod <input type="checkbox"/> Jetted <input type="checkbox"/> Bored <input type="checkbox"/> Reverse rotary		
			8. Use: <input type="checkbox"/> Domestic <input type="checkbox"/> Public supply <input type="checkbox"/> Industry <input type="checkbox"/> Irrigation <input type="checkbox"/> Air conditioning <input checked="" type="checkbox"/> Stock <input type="checkbox"/> Lawn <input type="checkbox"/> Oil field water <input type="checkbox"/> Other		
			9. Casing: Material PVC Height: Above or below Threaded <input type="checkbox"/> Welded <input checked="" type="checkbox"/> Surface 12 in. RMP <input type="checkbox"/> PVC 5" Weight 1 1/2 lbs./ft. Dia. 5 in. to 4 1/2 ft. depth Wall Thickness: inches or Dia. <input type="checkbox"/> in. to <input type="checkbox"/> ft. depth gage No. 214		
			10. Screen: Manufacturer's name _____ Type slots Dia. 5 Slot/gauze 1/8" Length 10 Set between 27 ft. and 37 ft. _____ ft. and _____ ft. Gravel pack? <input checked="" type="checkbox"/> yes Size range of material CMA 1/4-1/8"		
			11. Static water level: _____ mg./day/yr. 19 ft. below land surface Date 4/28		
			12. Pumping level below land surfaces: 40 ft. after 1 hrs. pumping 4 1/2 g.p.m. 40 ft. after 4 hrs. pumping 4 1/2 g.p.m. Estimated maximum yield 4 1/2 g.p.m.		
			13. Water sample submitted: _____ mo./day/yr. <input type="checkbox"/> Yes <input checked="" type="checkbox"/> No Date _____		
			14. Well head completion: <input type="checkbox"/> Pitless adapter 12" inches above grade		
			15. Well grouted? <input checked="" type="checkbox"/> yes With: <input checked="" type="checkbox"/> Neat cement <input type="checkbox"/> Bentonite <input type="checkbox"/> Concrete Depth: From 4 ft. to 14 ft.		
			16. Nearest source of possible contamination: _____ ft. _____ Direction _____ Type none Well disinfected upon completion? <input checked="" type="checkbox"/> Yes <input type="checkbox"/> No		
			17. Pump: <input checked="" type="checkbox"/> Not installed Manufacturer's name _____ Model number _____ HP _____ Volts _____ Length of drop pipe _____ ft. capacity _____ g.p.m. Type: <input type="checkbox"/> Submersible <input type="checkbox"/> Turbine <input type="checkbox"/> Jet <input type="checkbox"/> Reciprocating <input type="checkbox"/> Centrifugal <input type="checkbox"/> Other		
			(Use a second sheet if needed)		
18. Elevation: Topography: <input type="checkbox"/> Hill <input type="checkbox"/> Slope <input type="checkbox"/> Upland <input type="checkbox"/> Valley	19. Remarks: Well on fairly level ground 14' West of old well		20. Water well contractor's certification: This well was drilled under my jurisdiction and this report is true to the best of my knowledge and belief. Rush Water Well Service 310 Business name Natoma, Kansas 67651 License No. _____ Address _____ Signed Oscar Rush Date 4/29 Authorized representative		

Forward the white, blue and pink copies to the Department of Health and Environment

Form WWC-5