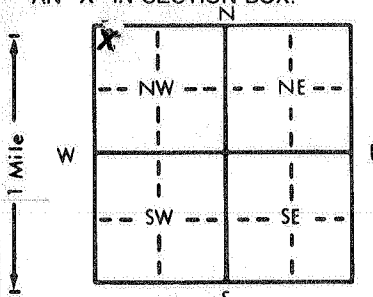


1 LOCATION OF WATER WELL: Fraction NW 1/4 NW 1/4 NW 1/4 Section Number 18 Township Number T 10 S Range Number R 16 **EW**
 County: Rooks

Distance and direction from nearest town or city street address of well if located within city?
1 mile East of Codell, Kansas

2 WATER WELL OWNER: Liberty Enterprises
 RR#, St. Address, Box # : 308 West Mill Board of Agriculture, Division of Water Resource
 City, State, ZIP Code : Plainville, Kansas 67663 Application Number:

3 LOCATE WELL'S LOCATION WITH AN "X" IN SECTION BOX:


4 DEPTH OF COMPLETED WELL: 44 ft. ELEVATION: Valley
 Depth(s) Groundwater Encountered 1. 20 ft. 2. 20 ft. 3. 20 ft.
 WELL'S STATIC WATER LEVEL 20 ft. below land surface measured on mo/day/yr 6/29/89
 Pump test data: Well water was 24 ft. after 2 hours pumping 20 gpm
 Est. Yield 20 gpm: Well water was 24 ft. after 2 hours pumping 20 gpm
 Bore Hole Diameter 70 in. to 44 ft., and 44 in. to 44 ft.
 WELL WATER TO BE USED AS: 1 5 Public water supply 8 Air conditioning 11 Injection well
1 Domestic 3 Feedlot 6 Oil field water supply 9 Dewatering 12 Other (Specify below)
2 Irrigation 4 Industrial 7 Lawn and garden only 10 Monitoring well
 Was a chemical/bacteriological sample submitted to Department? Yes No X; If yes, mo/day/yr sample was submitted
 Water Well Disinfected? Yes X No

5 TYPE OF BLANK CASING USED: 2 5 Wrought iron 8 Concrete tile CASING JOINTS: Glued X Clamped
1 Steel 3 RMP (SR) 6 Asbestos-Cement 9 Other (specify below) Welded
2 PVC 4 ABS 7 Fiberglass Threaded
 Casing height above land surface 24 in., weight 2.29 lbs./ft. Wall thickness or gauge No. 26
 TYPE OF SCREEN OR PERFORATION MATERIAL: 7 7 PVC 10 Asbestos-cement
1 Steel 3 Stainless steel 5 Fiberglass 8 RMP (SR) 11 Other (specify)
2 Brass 4 Galvanized steel 6 Concrete tile 9 ABS 12 None used (open hole)
 SCREEN OR PERFORATION OPENINGS ARE: 8 5 Gauzed wrapped 8 Saw cut 11 None (open hole)
1 Continuous slot 3 Mill slot 6 Wire wrapped 9 Drilled holes
2 Louvered shutter 4 Key punched 7 Torch cut 10 Other (specify)
 SCREEN-PERFORATED INTERVALS: From 24 ft. to 44 ft., From 24 ft. to 44 ft., From 24 ft. to 44 ft.
 GRAVEL PACK INTERVALS: From 20 ft. to 44 ft., From 20 ft. to 44 ft., From 20 ft. to 44 ft.

6 GROUT MATERIAL: 1 1 Neat cement 2 Cement grout 3 Bentonite 4 Other
 What is the nearest source of possible contamination: None 10 Livestock pens 14 Abandoned water well
1 Septic tank 4 Lateral lines 7 Pit privy 11 Fuel storage 15 Oil well/Gas well
2 Sewer lines 5 Cess pool 8 Sewage lagoon 12 Fertilizer storage 16 Other (specify below)
3 Watertight sewer lines 6 Seepage pit 9 Feedyard 13 Insecticide storage

Direction from well? How many feet?

FROM	TO	LITHOLOGIC LOG	FROM	TO	PLUGGING INTERVALS
0	20	Topsoil			
20	35	Gravel			
35	44	Shale			

7 CONTRACTOR'S OR LANDOWNER'S CERTIFICATION: This water well was (1) constructed, (2) reconstructed, or (3) plugged under my jurisdiction and was completed on (mo/day/year) 6/29/89 and this record is true to the best of my knowledge and belief. Kansas Water Well Contractor's License No. 199. This Water Well Record was completed on (mo/day/yr) 6/29/89 under the business name of Karst Water Well Drilling & Service, Inc by (signature)

INSTRUCTIONS: Use typewriter or ball point pen. PLEASE PRESS FIRMLY and PRINT clearly. Please fill in blanks, underline or circle the correct answers. Send top three copies to Kansas Department of Health and Environment, Bureau of Water Protection, Topeka, Kansas 66620-7320. Telephone: 913-296-5514. Send one to WATER WELL OWNER and retain one for your records.