USE TYPEWRITER OR BALL POINT PEN-PRESS FIRMLY, PRINT CLEARLY.

T	R	EW	sec	1/4	1/4	1/4	No.			

WATER WELL RECORD
KSA 82a-1201-1215

Kansas State Dept. Of Health
(Water Well Contractors)
Forbes-Bldg. 740
Topeka, Kansas 66620

SW¼ SW¼ SW¼

1 Location of well:	County	Township name	Fraction	Section number	Town number	Range number
	Rooks	South Plainville	~~NE¼ SW¼ SW¼~~	14	10	18 W

Distance and direction from nearest town or city: 3½ South of
Street address of well location if in city: Plainville

3 Owner of well: D.J. Finnesy
Address: Plainville Kans

Locate with "X" in section below:

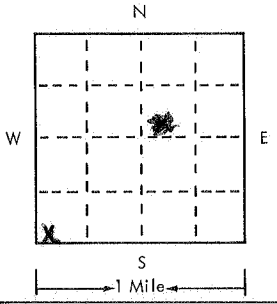

Sketch map:

4 Well depth: 72 ft. Date of completion 6/25/79
Well diameter 5 in.

5 ☐ Cable tool ☒ Rotary ☐ Driven ☐ Dug
☐ Hollow rod ☐ Jetted ☐ Bored ☐ Reverse rotary

6 Use: ☒ Domestic ☐ Public supply ☐ Industry
☐ Irrigation ☐ Air conditioning ☐ Commercial
☐ Test well ☐

7 Casing: Material PVC Height: above/below
Threaded ☐ Welded ☐ Surface 24 in.
Diam. Weight ~~20~~ 260 lbs./ft.
5 in. to 22 ft. depth Drive shoe? ☐ Yes ☒ No
___ in. to ___ ft. depth

2

Type and color of material	From	To
Top Soil + Clay	0	15
Sand	15	68
Blue Shale	68	72

(use a second sheet if needed)

8 Screen: None Used Perforated Casing
Manufacturer
Type PVC Dia. 5
Slot/gauze Slot Length 3½ inches
Set between 48 ft. and 68 ft. 20 ft.
Fittings:
Gravel pack ☒ Yes ☐ No Size range of material CMR

9 Static water level:
45 ft. below land surface Date 6/25/79

10 Pumping level below land surfaces:
___ ft. after ___ hrs. pumping ___ g.p.m.
___ ft. after ___ hrs. pumping ___ g.p.m.
Estimated maximum yield 10 g.p.m.

11 Water sample submitted:
☐ Yes ☒ No Date ___

12 Well head completion:
☐ Pitless adapter ☒ 24 inches above grade

13 Well grouted? ☒ Yes ☐ No
☒ Neat cement ☐ Bentonite ☐
Depth: From 0 ft. to 15 ft.

14 Nearest source of possible contamination: None
ft. ___ Direction ___ Type ___
Well disinfected upon completion? ☐ Yes ☐ No

15 Pump: ☒ Not installed
Manufacturer's name
Model number ___ HP ___ Volts ___
Length of drop pipe ___ ft. capacity ___ g.m.p.
Type:
☐ Submersible ☐ Turbine
☐ Jet ☐ Reciprocating
☐ Certrifugal ☐ Other

16 Remarks: elevation
Owner will finish well to state requirements

Topography:
☒ Hill
☐ Slope
☐ Upland
☐ Valley

17 Water well contractor's certification:
This well was drilled under my jurisdiction and this report is true to the best of my knowledge and belief.
Jones Bros Water Well Drlg 285
Business name License No.
Address Box 68 RR 2 Plainville
Signed Samuel F Jones Date 7/9/79
Authorized representative

10 18W 14 SWSWSW

Forward the white, blue and pink copies to the Kansas State Dept. Of Health.

Form WWC-5