


1 LOCATION OF WATER WELL: Fraction NW 1/4 NW 1/4 NE 1/4 Section Number 26 Township Number T 10 S Range Number R 18 EW
 County: Rock

Distance and direction from nearest town or city street address of well if located within city?
5 miles South of Plainville Kansas & 300 feet East & 400 South

2 WATER WELL OWNER: Fester Shepard
 RR#, St. Address, Box #: R2 Box 115 Plainville Kansas Board of Agriculture, Division of Water Resource
 City, State, ZIP Code: 67603 Application Number:

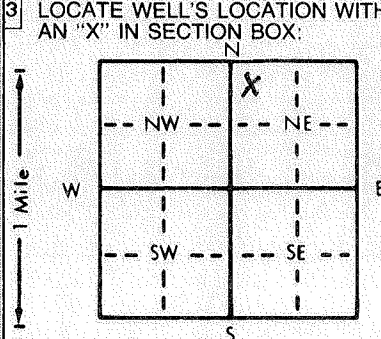

4 DEPTH OF COMPLETED WELL... 165 ft. ELEVATION:
 Depth(s) Groundwater Encountered 1. 160 ft. 2. ft. 3. ft.
 WELL'S STATIC WATER LEVEL 32 ft. below land surface measured on mo/day/yr
 Pump test data: Well water was 80 ft. after 2 hours pumping 60 gpm
 Est. Yield gpm: Well water was ft. after hours pumping gpm
 Bore Hole Diameter 10 in. to ft. and in. to ft.
 WELL WATER TO BE USED AS: 5 Public water supply 8 Air conditioning 11 Injection well
 Domestic 3 Feedlot 6 Oil field water supply 9 Dewatering 12 Other (Specify below)
 2 Irrigation 4 Industrial 7 Lawn and garden only 10 Monitoring well
 Was a chemical/bacteriological sample submitted to Department? Yes No If yes, mo/day/yr sample was submitted

5 TYPE OF BLANK CASING USED: 5 Wrought iron 8 Concrete tile CASING JOINTS: Glued Clamped
 1 Steel 3 RMP (SR) 6 Asbestos-Cement 9 Other (specify below) Welded
 PVC 4 ABS 7 Fiberglass Threaded
 Blank casing diameter 1.45 in. to 0 ft. Dia. in. to ft. Dia. in. to ft.
 Casing height above land surface 20 in., weight 200 PST lbs./ft. Wall thickness or gauge No.
 TYPE OF SCREEN OR PERFORATION MATERIAL: PVC 10 Asbestos-cement
 1 Steel 3 Stainless steel 5 Fiberglass 8 RMP (SR) 11 Other (specify)
 2 Brass 4 Galvanized steel 6 Concrete tile 9 ABS 12 None used (open hole)
 SCREEN OR PERFORATION OPENINGS ARE: 5 Gauzed wrapped Saw cut 11 None (open hole)
 1 Continuous slot 3 Mill slot 6 Wire wrapped 9 Drilled holes
 2 Louvered shutter 4 Key punched 7 Torch cut 10 Other (specify)
 SCREEN-PERFORATED INTERVALS: From 145 ft. to 165 ft. From ft. to ft.
 GRAVEL PACK INTERVALS: From 20 ft. to 165 ft. From ft. to ft.

6 GROUT MATERIAL: 1 Neat cement Cement grout 3 Bentonite 4 Other
 Grout Intervals: From 0 ft. to 20 ft. From ft. to ft. From ft. to ft.
 What is the nearest source of possible contamination:
 1 Septic tank 4 Lateral lines 7 Pit privy 10 Livestock pens 14 Abandoned water well
 2 Sewer lines 5 Cess pool 8 Sewage lagoon 11 Fuel storage 15 Oil well/Gas well
 3 Watertight sewer lines 6 Seepage pit 9 Feedyard 12 Fertilizer storage 16 Other (specify below)
 13 Insecticide storage Dam
 Direction from well? How many feet? 1200

FROM	TO	LITHOLOGIC LOG	FROM	TO	PLUGGING INTERVALS
0	15	Surface clay			
15	35	yellow sand clay			
35	60	hard clay			
60	110	gray shale			
110	125	light gray shale			
125	160	white water rock			
160	165	purple shaly rock			
165	167	blue sand shale			

7 CONTRACTOR'S OR LANDOWNER'S CERTIFICATION: This water well was (1) constructed, (2) reconstructed, or (3) plugged under my jurisdiction and was completed on (mo/day/year) 5-1-90 and this record is true to the best of my knowledge and belief. Kansas Water Well Contractor's License No. 444 This Water Well Record was completed on (mo/day/yr) 5-1-90 under the business name of Anderson Drilling by (signature) Andy Anderson