


1] LOCATION OF WATER WELL: County: Roos Fraction: NE 1/4 SE 1/4 SW 1/4 Section Number: 26 Township Number: T 10 S Range Number: R 18 EW

Distance and direction from nearest town or city street address of well if located within city?
Six miles south of Plainville, Kansas + 300 feet West + 600 feet north

2] WATER WELL OWNER: Foster Shepard
 RR#, St. Address, Box #: Route 2 Box 115 Plainville Kansas
 City, State, ZIP Code: 67663
 Board of Agriculture, Division of Water Resources
 Application Number:

3] LOCATE WELL'S LOCATION WITH AN "X" IN SECTION BOX:

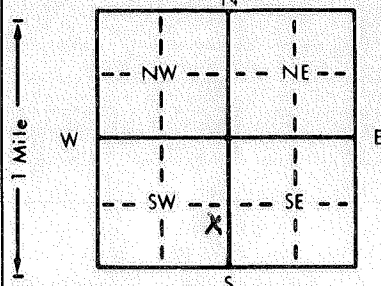

4] DEPTH OF COMPLETED WELL: 145 ft. ELEVATION:
 Depth(s) Groundwater Encountered 1. 140 ft. 2. ft. 3. ft.
 WELL'S STATIC WATER LEVEL: 6.2 ft. below land surface measured on mo/day/yr 4-30-98
 Pump test data: Well water was 6.2 ft. after 2 hours pumping 60 gpm
 Est. Yield 100 gpm. Well water was ft. after hours pumping gpm
 Bore Hole Diameter: 9 in. to 1.45 ft., and in. to ft.
 WELL WATER TO BE USED AS:
 Domestic Feedlot Oil field water supply Dewatering Other (Specify below)
 Irrigation Industrial Lawn and garden only Monitoring well
 Was a chemical/bacteriological sample submitted to Department? Yes.....No.....; If yes, mo/day/yr sample was submitted
 Water Well Disinfected? Yes No

5] TYPE OF BLANK CASING USED:
 1 Steel 3 RMP (SR) 6 Asbestos-Cement 9 Other (specify below)
 2 PVC 4 ABS 7 Fiberglass
 Blank casing diameter: 5 in. to 1.25 ft., Dia. in. to ft., Dia. in. to ft.
 Casing height above land surface: 24" in., weight 200 PST lbs./ft. Wall thickness or gauge No.

TYPE OF SCREEN OR PERFORATION MATERIAL:
 1 Steel 3 Stainless steel 5 Fiberglass 8 RMP (SR) 10 Asbestos-cement
 2 Brass 4 Galvanized steel 6 Concrete tile 9 ABS 11 Other (specify) 12 None used (open hole)

SCREEN OR PERFORATION OPENINGS ARE:
 1 Continuous slot 3 Mill slot 5 Gauzed wrapped 8 Saw cut 11 None (open hole)
 2 Louvered shutter 4 Key punched 6 Wire wrapped 9 Drilled holes

SCREEN-PERFORATED INTERVALS: From 125 ft. to 145 ft., From ft. to ft., From ft. to ft., From ft. to ft.

GRAVEL PACK INTERVALS: From 20 ft. to 145 ft., From ft. to ft., From ft. to ft., From ft. to ft.

6] GROUT MATERIAL: 1 Neat cement 2 Cement grout 3 Bentonite 4 Other
 Grout Intervals: From 0 ft. to 20 ft., From ft. to ft., From ft. to ft., From ft. to ft.

What is the nearest source of possible contamination:
 1 Septic tank 4 Lateral lines 7 Pit privy 10 Livestock pens 14 Abandoned water well
 2 Sewer lines 5 Cess pool 8 Sewage lagoon 11 Fuel storage 15 Oil well/Gas well
 3 Watertight sewer lines 6 Seepage pit 9 Feedyard 12 Fertilizer storage 16 Other (specify below)

Direction from well? How many feet? Down 2000

FROM	TO	LITHOLOGIC LOG	FROM	TO	PLUGGING INTERVALS
0	20	Surface Clays			
20	40	yellow potstone Rock			
40	65	Hard Clays			
65	100	Gray shale			
100	140	W. light Rock			
140	145	W. pink shale Rock			
145	147	Blk shale			

7] CONTRACTOR'S OR LANDOWNER'S CERTIFICATION: This water well was (1) constructed, (2) reconstructed, or (3) plugged under my jurisdiction and was completed on (mo/day/year) 4-30-1990 and this record is true to the best of my knowledge and belief. Kansas Water Well Contractor's License No. 444 This Water Well Record was completed on (mo/day/yr) 4-3-98 under the business name of Anderson Drilling by (signature) Andy Anderson