

1 LOCATION OF WATER WELL:

Fraction

Section Number

Township Number

Range Number

County: Rooks

NE 1/4 SE 1/4 NE 1/4

7

T 10 S

R 19 E W

Distance and direction from nearest town or city street address of well if located within city? Approximately 2 1/4 miles west and 2 1/4 miles south of Zurich

Global Positioning Systems (decimal degrees, min. of 4 digits)

Latitude: 39.200881

Longitude: -99.475458

Elevation: unknown

Datum: NAD 83

Data Collection Method: WAAS GPS Unit

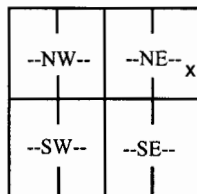
2 WATER WELL OWNER: Rooks County RWD #3

RR#, St. Address, Box # : P.O. Box 382

City, State, ZIP Code : Plainville, KS 67663

3 LOCATE WELL'S LOCATION WITH AN "X" IN SECTION BOX:

N

**4 DEPTH OF COMPLETED WELL**

88 ft.

Depth(s) Groundwater Encountered (1) _____ ft. (2) _____ ft. (3) _____ ft.

WELL'S STATIC WATER LEVEL 32.88 ft. below land surface measured on mo/day/yr. 9-5-06

Pump test data: Well water was not checked ft. after _____ hours pumping _____ gpm

Est. Yield unknown gpm: Well water was _____ ft. after _____ hours pumping _____ gpm

WELL WATER TO BE USED AS: 5 Public water supply 8 Air conditioning 11 Injection well

1 Domestic 3 Feedlot 6 Oil field water supply 9 Dewatering 12 Other (Specify below)

2 Irrigation 4 Industrial 7 Domestic (lawn & garden) 10 Monitoring well **Test Well**Was a chemical/bacteriological sample submitted to Department? Yes _____ No If yes, mo/day/yr _____Sample was submitted _____ Water well disinfected? Yes _____ No **5 TYPE OF CASING USED:**5 Wrought Iron 8 Concrete tile CASING JOINTS: Glued Clamped

1 Steel 3 RMP (SR) 6 Asbestos-Cement 9 Other (specify below) Welded _____

2 PVC 4 ABS 7 Fiberglass Threaded _____

Blank casing diameter 5 in. to 76 ft., Diameter _____ in. to _____ ft., Diameter _____ in. to _____ ft.

Casing height above land surface 24 in., weight 2.36 lbs./ft. Wall thickness or gauge No. .214

TYPE OF SCREEN OR PERFORATION MATERIAL:

1 Steel 3 Stainless Steel 5 Fiberglass 7 PVC 9 ABS 11 Other (Specify) _____

2 Brass 4 Galvanized Steel 6 Concrete tile 8 RM (SR) 10 Asbestos-Cement 12 None used (open hole)

SCREEN OR PERFORATION OPENINGS ARE:

1 Continuous slot 3 Mill slot 5 Gauzed wrapped 7 Torch cut 9 Drilled holes 11 None (open hole)

2 Louvered shutter 4 Key punched 6 Wire wrapped 8 Saw Cut 10 Other (Specify) _____

SCREEN-PERFORATED INTERVALS: From 76 ft. to 86 ft., From _____ ft. to _____ ft.

From _____ ft. to _____ ft., From _____ ft. to _____ ft.

GRAVEL PACK INTERVALS: From 25 ft. to 91 ft., From _____ ft. to _____ ft.

From _____ ft. to _____ ft., From _____ ft. to _____ ft.

6 GROUT MATERIAL: 1 Neat Cement 2 Cement grout 3 Bentonite 4 Other _____ Bentonite Holeplug

Grout Intervals: From _____ ft. to _____ ft., From _____ ft. to _____ ft., From 0 ft. to 25 ft.

What is the nearest source of possible contamination:

1 Septic tank 4 Lateral lines 7 Pit privy 10 Livestock pens 13 Insecticide Storage 16 Other (specify below)

2 Sewer lines 5 Cess pool 8 Sewage lagoon 11 Fuel storage 14 Abandoned water well

3 Watertight sewer lines 6 Seepage pit 9 Feedyard 12 Fertilizer Storage 15 Oil well/gas well **None known**

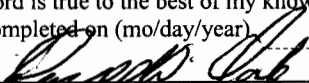
Direction from well? _____ How many feet? _____

FROM	TO	LITHOLOGIC LOG	FROM	TO	PLUGGING INTERVALS
0	5	Topsoil	86	89	Clay, yellow and white, hard
5	7	Clay, brown, sandy, soft	89	91	Shale, black, hard
7	14	Sand, coarse to very fine, loose, clean			
14	17	Clay, tannish brown, hard			
17	31	Sand and gravel, medium to fine, loose, clean			
31	32	Clay, brown, hard			
32	44	Sand and gravel, medium to fine, clean			
44	47	Clay, tan, hard			
47	86	Sand, coarse to very fine with gravel, fine and thin clay streaks, white, clean			

7 CONTRACTOR'S OR LANDOWNER'S CERTIFICATION: This water well was (1) constructed (2) reconstructed (3) plugged under my jurisdiction and was completed on (mo/day/year) 9-5-06 and this record is true to the best of my knowledge and belief.

Kansas Water Well Contractor's License No. 185 This Water Well Record was completed on (mo/day/year) 9-7-06

Under the business name of Clarke Well & Equipment, Inc.

by (signature) 

INSTRUCTIONS: Use typewriter or ball point pen. PLEASE PRESS FIRMLY and PRINT clearly. Please fill in blanks, underline or circle the correct answers. Send top three copies to Kansas Department of Health and Environment, Bureau of Water, Geology Section, 1000 SW Jackson St., Suite 420, Topeka, Kansas 66612-1367. Telephone 785-296-5522. Send one to WATER WELL OWNER and retain one for your records. Fee of \$5.00 for each constructed well.