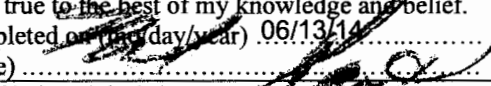


WATER WELL RECORD

Form WWC-5

Division of Water Resources App. No.

1 LOCATION OF WATER WELL: County: Rooks		Fraction NE ¼ NE ¼ NE ¼ ¼		Section Number 1	Township No. T 10 S	Range Number R 19 <input type="checkbox"/> E <input checked="" type="checkbox"/> W				
Street/Rural Address of Well Location; if unknown, distance & direction from nearest town or intersection: If at owner's address, check here <input checked="" type="checkbox"/> .				Global Positioning System (GPS) information: Latitude: (in decimal degrees) Longitude: (in decimal degrees) Elevation: Datum: <input type="checkbox"/> WGS 84, <input type="checkbox"/> NAD 83, <input type="checkbox"/> NAD 27 Collection Method: <input type="checkbox"/> GPS unit (Make/Model:) <input type="checkbox"/> Digital Map/Photo, <input type="checkbox"/> Topographic Map, <input type="checkbox"/> Land Survey Est. Accuracy: <input type="checkbox"/> <3 m, <input type="checkbox"/> 3-5 m, <input type="checkbox"/> 5-15 m, <input type="checkbox"/> >15 m						
2 WATER WELL OWNER: Dan Cunningham RR#, Street Address, Box #: 2545 13 Rd City, State, ZIP Code : Plainville, Ks 67663										
3 LOCATE WELL WITH AN "X" IN SECTION BOX: N <div style="display: flex; align-items: center; justify-content: center;"> <div style="text-align: center; margin-right: 10px;">W</div> <table border="1" style="border-collapse: collapse; text-align: center;"> <tr> <td style="padding: 5px;">--NW--</td> <td style="padding: 5px;">--NE--</td> </tr> <tr> <td style="padding: 5px;">--SW--</td> <td style="padding: 5px;">--SE--</td> </tr> </table> <div style="text-align: center; margin-left: 10px;">E</div> </div> <div style="text-align: center; margin-top: 5px;">S</div> <div style="text-align: center; margin-top: 5px;"> -----1 mile----- </div>		--NW--	--NE--	--SW--	--SE--	4 DEPTH OF COMPLETED WELL 105 ft. Depth(s) Groundwater Encountered (1) 60 ft. (2) ft. (3) ft. WELL'S STATIC WATER LEVEL 54 ft. below land surface measured on mo/day/yr. 05/27/14 Pump test data: Well water was ft. after hours pumping gpm EST. YIELD 20 gpm. Well water was ft. after hours pumping gpm Bore Hole Diameter 10 in. to 105 ft., and in. to ft. WELL WATER TO BE USED AS: <input type="checkbox"/> Public water supply <input type="checkbox"/> Geothermal <input type="checkbox"/> Injection well <input checked="" type="checkbox"/> Domestic <input type="checkbox"/> Feedlot <input type="checkbox"/> Oil field water supply <input type="checkbox"/> Dewatering <input type="checkbox"/> Other (Specify below) <input type="checkbox"/> Irrigation <input type="checkbox"/> Industrial <input type="checkbox"/> Domestic-lawn & garden <input type="checkbox"/> Monitoring well Was a chemical/bacteriological sample submitted to Department? <input type="checkbox"/> Yes <input type="checkbox"/> No If yes, mo/day/yr sample was submitted Water well disinfected? <input checked="" type="checkbox"/> Yes <input type="checkbox"/> No				
--NW--	--NE--									
--SW--	--SE--									
5 TYPE OF CASING USED: <input type="checkbox"/> Steel <input checked="" type="checkbox"/> PVC <input type="checkbox"/> Other CASING JOINTS: <input checked="" type="checkbox"/> Glued <input type="checkbox"/> Clamped <input type="checkbox"/> Welded <input type="checkbox"/> Threaded Casing diameter 5 in. to 105 ft., Diameter in. to ft., Diameter in. to ft. Casing height above land surface 12 in., Weight 2.91 lbs./ft., Wall thickness or gauge No. 21 TYPE OF SCREEN OR PERFORATION MATERIAL: <input type="checkbox"/> Steel <input type="checkbox"/> Stainless Steel <input checked="" type="checkbox"/> PVC <input type="checkbox"/> Other (Specify) <input type="checkbox"/> Brass <input type="checkbox"/> Galvanized Steel <input type="checkbox"/> None used (open hole) SCREEN OR PERFORATION OPENINGS ARE: <input type="checkbox"/> Continuous slot <input type="checkbox"/> Mill slot <input type="checkbox"/> Gauze wrapped <input type="checkbox"/> Torch cut <input type="checkbox"/> Drilled holes <input type="checkbox"/> None (open hole) <input type="checkbox"/> Louvered shutter <input type="checkbox"/> Key punched <input type="checkbox"/> Wire wrapped <input checked="" type="checkbox"/> Saw cut <input type="checkbox"/> Other (specify) SCREEN-PERFORATED INTERVALS: From 105 ft. to 65 ft., From ft. to ft. From ft. to ft., From ft. to ft. GRAVEL PACK INTERVALS: From 105 ft. to 20 ft., From ft. to ft. From ft. to ft., From ft. to ft.										
6 GROUT MATERIAL: <input type="checkbox"/> Neat cement <input type="checkbox"/> Cement grout <input type="checkbox"/> Bentonite <input type="checkbox"/> Other Grout Intervals: From 20 ft. to 0 ft., From ft. to ft., From ft. to ft. What is the nearest source of possible contamination: <input type="checkbox"/> Septic tank <input type="checkbox"/> Lateral lines <input type="checkbox"/> Pit privy <input type="checkbox"/> Livestock pens <input type="checkbox"/> Insecticide storage <input type="checkbox"/> Other (specify below) <input type="checkbox"/> Sewer lines <input type="checkbox"/> Cesspool <input type="checkbox"/> Sewage lagoon <input type="checkbox"/> Fuel storage <input type="checkbox"/> Abandoned water well <input type="checkbox"/> Watertight sewer lines <input type="checkbox"/> Seepage pit <input type="checkbox"/> Feedyard <input type="checkbox"/> Fertilizer storage <input type="checkbox"/> Oil well/gas well Direction from well Distance from well										
FROM	TO	LITHOLOGIC LOG	FROM	TO	LITHO. LOG (cont.) or PLUGGING INTERVALS					
0	4	Top Soil								
4	17	Gumbo clay								
17	25	Sand								
25	30	Clay								
30	32	Sand								
32	45	Rock								
45	60	Clay								
60	85	Sand, rock and clay								
85	95	Sand								
95	105	Brown Shale								
7 CONTRACTOR'S OR LANDOWNER'S CERTIFICATION: This water well was <input type="checkbox"/> constructed, <input type="checkbox"/> reconstructed, or <input type="checkbox"/> plugged under my jurisdiction and was completed on (mo/day/year) 05/28/14 and this record is true to the best of my knowledge and belief. Kansas Water Well Contractor's License No. 0199 This Water Well Record was completed on (mo/day/year) 06/13/14 under the business name of Karst Water Well Drilling & Service, Inc. by (signature) 										
INSTRUCTIONS: Use typewriter or ball point pen. <u>PLEASE PRESS FIRMLY</u> and <u>PRINT</u> clearly. Please fill in blanks and check the correct answers. Send one copy to Kansas Department of Health and Environment, Bureau of Water, Geology Section, 1000 SW Jackson St., Suite 420, Topeka, Kansas 66612-1367. Telephone 785-296-5524. Send one copy to WATER WELL OWNER and retain one for your records. Include fee of \$5.00 for each constructed well. Visit us at http://www.kdheks.gov/waterwell/index.html										