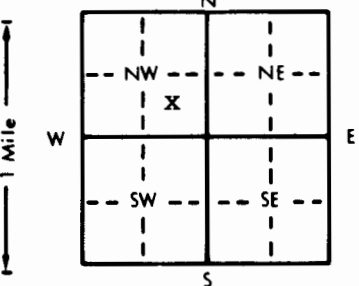


Plugging Record
WATER WELL RECORD Form WWC-5 KSA 82a-1212

1 LOCATION OF WATER WELL: Fraction 1/4 SE 1/4 NW 1/4 Section Number 33 Township Number T 10 S Range Number R 2 E/W
County: Ottawa OT

Distance and direction from nearest town or city street address of well if located within city?
200 E. Hanes Wells, KS 67488

2 WATER WELL OWNER: C.L. Comfort
RR#, St. Address, Box # : 4620 Turnberry Dr Board of Agriculture, Division of Water Resources
City, State, ZIP Code : Lawrence, KS 66047 Application Number:


3 LOCATE WELL'S LOCATION WITH AN "X" IN SECTION BOX:


4 DEPTH OF COMPLETED WELL... 21 ft. ELEVATION:
Depth(s) Groundwater Encountered 1. 12 ft. 2. ft. 3. ft.
WELL'S STATIC WATER LEVEL ... 12 ft. below land surface measured on mo/day/yr 03/01/00
Pump test data: Well water was ft. after hours pumping gpm
Est. Yield gpm: Well water was ft. after hours pumping gpm
Bore Hole Diameter in. to ft., and in. to ft.
WELL WATER TO BE USED AS: 5 Public water supply 8 Air conditioning 11 Injection well
1 Domestic 3 Feedlot 6 Oil field water supply 9 Dewatering 12 Other (Specify below)
~~2 Irrigation~~ 4 Industrial 7 Lawn and garden only 10 Monitoring well
Was a chemical/bacteriological sample submitted to Department? Yes No xx If yes, mo/day/yr sample was submitted
Water Well Disinfected? Yes xx No

5 TYPE OF BLANK CASING USED: 5 Wrought iron 8 Concrete tile CASING JOINTS: Glued Clamped
1 Steel 3 RMP (SR) 6 Asbestos-Cement 9 Other (specify below) Welded
2 PVC 4 ABS 7 Fiberglass 3' dia dug well Threaded
Blank casing diameter in. to ft., Dia rock lined ft., Dia in. to ft.
Casing height above land surface in., weight lbs./ft. Wall thickness or gauge No.
TYPE OF SCREEN OR PERFORATION MATERIAL: 7 PVC 10 Asbestos-cement
1 Steel 3 Stainless steel 5 Fiberglass 8 RMP (SR) 11 Other (specify)
2 Brass 4 Galvanized steel 6 Concrete tile 9 ABS 12 None used (open hole)
SCREEN OR PERFORATION OPENINGS ARE: 5 Gauzed wrapped 8 Saw cut 11 None (open hole)
1 Continuous slot 3 Mill slot 6 Wire wrapped 9 Drilled holes
2 Louvered shutter 4 Key punched 7 Torch cut 10 Other (specify)
SCREEN-PERFORATED INTERVALS: From ft. to ft., From ft. to ft.
From ft. to ft., From ft. to ft.
GRAVEL PACK INTERVALS: From ft. to ft., From ft. to ft.
From ft. to ft., From ft. to ft.

6 GROUT MATERIAL: 1 Neat cement 2 Cement grout 3 Bentonite 4 Other
Grout Intervals: From 2 ft. to 3 ft., From ft. to ft., From ft. to ft.
What is the nearest source of possible contamination:
1 Septic tank 4 Lateral lines 7 Pit privy 10 Livestock pens 14 Abandoned water well
2 Sewer lines xxxxxxxxxxxx 8 Sewage lagoon 11 Fuel storage 15 Oil well/Gas well
3 Watertight sewer lines 5 Cess pool 9 Feedyard 12 Fertilizer storage 16 Other (specify below)
6 Seepage pit 13 Insecticide storage
Direction from well? South How many feet? 200

FROM	TO	LITHOLOGIC LOG	FROM	TO	PLUGGING INTERVALS
			0'	2'	clay soil
			2'	3'	Bentonite plug
			3'	7'	clay soil
			7'	21'	sand

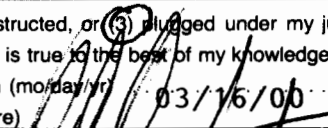7 CONTRACTOR'S OR LANDOWNER'S CERTIFICATION: This water well was (1) constructed, (2) reconstructed, or (3) plugged under my jurisdiction and was completed on (mo/day/year) 03/14/00 and this record is true to the best of my knowledge and belief. Kansas Water Well Contractor's License No. This Water Well Record was completed on (mo/day/yr) 03/16/00 under the business name of by (signature) 

INSTRUCTIONS: Use typewriter or ball point pen. PLEASE PRESS FIRMLY and PRINT clearly. Please fill in blanks, underline or circle the correct answers. Send for three copies to Kansas Department of Health and Environment, Bureau of Water, Topeka, Kansas 66620-0001. Telephone: 913-296-5545. Send one to WATER WELL OWNER and retain one for your records.

OFFICE USE ONLY
T
R
EW
SEC.
1/4
1/4
1/4