


1 LOCATION OF WATER WELL: County: <u>Ottawa</u>	Fraction <u>1/4 NE 1/4 SE 1/4</u>	Section Number <u>28</u>	Township Number <u>10</u>	Range Number <u>2 W</u>
--	--------------------------------------	-----------------------------	------------------------------	----------------------------

Distance and direction from nearest town or city street address of well if located within city?

2 WATER WELL OWNER: LeRoy Windhorst  
 RR #, St. Address, Box #: 212 Jefferson  
 City, State, ZIP Code: Wells KS 67467  
 Board of Agriculture, Division of Water Resources  
 Application Number: \_\_\_\_\_

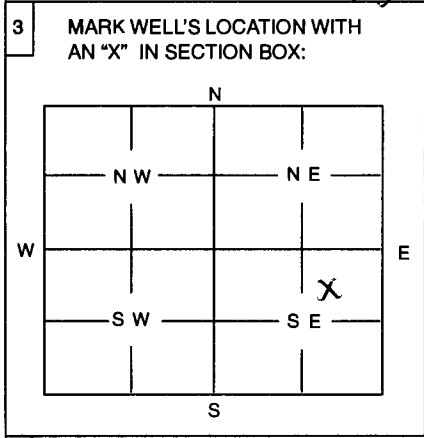

4 DEPTH OF WELL 78 ft.  
 WELL'S STATIC WATER LEVEL 54 ft.  
 WELL WAS USED AS:  
 1 Domestic      5 Public Water Supply      9 Dewatering  
 2 Irrigation    6 Oil Field Water Supply      10 Monitoring Well  
 3 Feedlot       7 Domestic (Lawn & Garden)    11 Injection Well  
 4 Industrial    8 Air Conditioning              12 Other Live Stock

Was a chemical / bacteriological sample submitted to Department? Yes ..... No X.....  
 If yes, mo/day/yr sample was submitted .....

Water Well Disinfected: Yes X..... No .....

5 TYPE OF BLANK CASING USED:  
 1 Steel    3 RMP (SR)    5 Wrought    7 Fiberglass    9 Other (Specify below)  
 2 PVC    4 ABS        6 Asbestos-Cement    8 Concrete Tile

Blank casing diameter 6 in.    Was casing pulled? Yes X..... No .....    If yes, how much 3 feet.....  
 Casing height above or below land surface 6 in.

6 GROUT PLUG MATERIAL:    1 Neat cement    2 Cement grout     3 Bentonite    4 Other .....

Grout Plug Intervals:    From 0 ft. to 3 ft.,    From ..... ft. to ..... ft.,    From ..... to ..... ft.

What is the nearest source of possible contamination:  
 1 Septic tank                      6 Seepage pit                      11 Fuel storage                      16 Other (specify below)  
 2 Sewer lines                      7 Pit privy                          12 Fertilizer storage  
 3 Watertight sewer lines        8 Sewage lagoon                    13 Insecticide storage  
 4 Lateral lines                      9 Feedyard                          14 Abandoned water well  
 5 Cess Pool                           10 Livestock                          15 Oil well/Gas well

Direction from well? Livestock Pasture    How many feet? 0

FROM	TO	PLUGGING MATERIALS
0	3 feet	top soil
3	6 feet	Bentonite Plug
6	24 ft	Subsoil
24	54 ft	Sand

7 CONTRACTOR'S OR LANDOWNER'S CERTIFICATION: This water well was plugged under my jurisdiction and was completed on (mo/day/year) 11-19-03 and this record is true to the best of my knowledge and belief. Kansas Water Well Contractor's License No. N/A This Water Well Record was completed on (mo/day/year) N/A under the business name of N/A by (signature) LeRoy Windhorst

INSTRUCTIONS: Use typewriter or ball point pen. Please press firmly and print clearly. Please fill in blanks, underline or circle the correct answers. Send top three copies to Kansas Department of Health and Environment, Bureau of Water, Topeka, Kansas 66620-0001. Telephone: 785/296-3565. Send one to Water Well Owner and retain one for your records.