

County: Ottawa Fraction NE SW SW SE Sec. 28 T 10 S R 2 E(W)

CORRECTION(S) TO WATER WELL COMPLETION RECORD (WWC-5)

(to rectify lacking or incorrect information)

Owner: Wiley Bradley

Location was listed as:

Location changed to:

Section-Township-Range: 28-10-02

28-10-2 W

Fraction (1/4 1/4 1/4): None Given

NE SW SW SE

Other changes: Initial statements: OT County

Changed to: Ottawa County

Comments:

Verification method: Well owner's address, area road map, other well records for same owner at same location, and mapping tool & aerial photos on KGS website. initials: DRA date: 11/20/2014

Submitted by: Kansas Geological Survey, Data Resources Library, 1930 Constant Ave., Lawrence, KS 66047-3726


to: Kansas Dept of Health & Environment, Bureau of Water, 1000 SW Jackson, Suite 420, Topeka, KS 66612-1367.

1 LOCATION OF WATER WELL:	Fraction	Section Number	Township Number	Range Number
County: <u>OT</u>	$\frac{1}{4}$ $\frac{1}{4}$ $\frac{1}{4}$	<u>28</u>	<u>10</u>	<u>02</u>

Distance and direction from nearest town or city street address of well if located within city?

2 WATER WELL OWNER:

RR #, St. Address, Box #: Wiley Bradley 2057 Mulberry Board of Agriculture, Division of Water Resources
 City, State, ZIP Code : Wells KS 67467 Application Number:

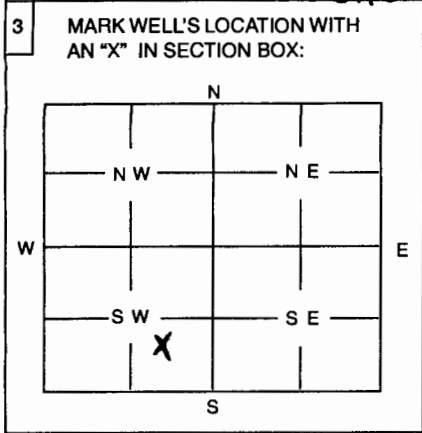

4 DEPTH OF WELL 96 ft

WELL'S STATIC WATER LEVEL 45 ft.

WELL WAS USED AS:

<input checked="" type="checkbox"/> Domestic	5 Public Water Supply	9 Dewatering
2 Irrigation	6 Oil Field Water Supply	10 Monitoring Well
3 Feedlot	7 Domestic (Lawn & Garden)	11 Injection Well
4 Industrial	8 Air Conditioning	12 Other

Was a chemical / bacteriological sample submitted to Department? Yes No
 If yes, mo/day/yr sample was submitted

Water Well Disinfected: Yes No

5 TYPE OF BLANK CASING USED:

1 <input checked="" type="checkbox"/> Steel	3 RMP (SR)	5 Wrought	7 Fiberglass	9 Other (Specify below)
<input checked="" type="checkbox"/> PVC	4 ABS	6 Asbestos-Cement	8 Concrete Tile	

Blank casing diameter 5 in. Was casing pulled? Yes No If yes, how much 5'
 Casing height above or below land surface 24 in.

6 GROUT PLUG MATERIAL: 1 Neat cement 2 Cement grout Bentonite 4 Other

Grout Plug Intervals: From 45 ft. to 2 ft., From ft. to ft., From to ft.

What is the nearest source of possible contamination:

1 Septic tank	6 Seepage pit	11 Fuel storage	16 Other (specify below)
2 Sewer lines	7 Pit privy	12 Fertilizer storage	
<input checked="" type="checkbox"/> Watertight sewer lines	8 Sewage lagoon	13 Insecticide storage	
4 Lateral lines	9 Feedyard	14 Abandoned water well	
5 Cess Pool	10 Livestock pens	15 Oil well/Gas well	

Direction from well? West How many feet? 500'

FROM	TO	PLUGGING MATERIALS
<u>96'</u>	<u>45'</u>	<u>Disinfected granular fill</u>
<u>45'</u>	<u>2'</u>	<u>Bentonite hole plug</u>

7 CONTRACTOR'S OR LANDOWNER'S CERTIFICATION: This water well was plugged under my jurisdiction and was completed on (mo/day/year) 9-13-14 and this record is true to the best of my knowledge and belief. Kansas Water Well Contractor's License No. This Water Well Record was completed on (mo/day/year)

by (signature) [Signature] under the business name of G.H. Pump + Windmill Service

INSTRUCTIONS: Use typewriter or ball point pen. Please press firmly and print clearly. Please fill in blanks, underline or circle the correct answers. Send top three copies to Kansas Department of Health and Environment, Bureau of Water, Topeka, Kansas 66620-0001. Telephone: 785/296-3565. Send one to Water Well Owner and retain one for your records.