

WATER WELL PLUGGING RECORD Form WWC-5P KSA 82a-1212 ID NO.

East Well


1 LOCATION OF WATER WELL: Fraction SW 1/4 NE 1/4 NE 1/4 Section Number 9 Township Number T 10 S Range Number 2 E W
 County: Ottawa

Street/Rural Address of Well Location; if unknown, distance & direction from nearest town or intersection: If at owner's address, check here 400' S & 550' W of Quartz Rd & 210th Rd, Wells, Kansas

Global Positioning Systems (GPS) information:
 Latitude: 39.203510 (in decimal degrees)
 Longitude: -97.539515 (in decimal degrees)
 Elevation: _____
 Horizontal Datum: WGS84, NAD83, NAD27
 Collection Method: _____

2 WATER WELL OWNER: Bruce Lafitte
 RR#, St. Address, Box #: 2223 Red Hawk Lane
 City, State ZIP Code: Salina, KS 67401

GPS unit (Make/Model: _____)
 Digital Map/Photo, Topographic Map, Land Survey
 Est. Accuracy: <3 m, 3-5 m, 5-15 m, >15 m

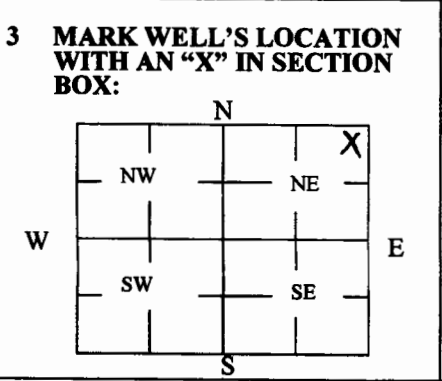

4 DEPTH OF WELL 79.2 ft.
 WELL'S STATIC WATER LEVEL 55.3 ft
 WELL WAS USED AS:
 Domestic Public Water Supply Dewatering
 Irrigation Oil Field Water Supply Monitoring
 Feedlot Domestic (Lawn & Garden) Injection Well
 Industrial Air Conditioning Other Old Hand Dug
 Was a chemical/bacteriological sample submitted to Department? Yes No

5 TYPE OF BLANK CASING USED:
 Steel RMP (SR) Wrought Fiberglass Other (Specify below)
 PVC ABS Asbestos-Cement Concrete Tile Sandstone Rock
 Blank casing diameter 42 in. Was casing pulled? Yes No If yes, how much 5'
 Casing height above or below land surface *None in.

6 GROUT PLUG MATERIAL: Neat cement Cement grout Bentonite Other See Below
 Grout Plug Intervals: From _____ ft. to _____ ft., From _____ ft. to _____ ft., From _____ ft. to _____ ft.

What is the nearest source of possible contamination:
 Septic tank Seepage pit Fuel storage Other (specify below)
 Sewer lines Pit privy Fertilizer storage Open pasture - None observed
 Watertight sewer lines Sewage lagoon Insecticide storage _____
 Lateral lines Feedyard Abandoned water well Direction from well? _____
 Cess pool Livestock pens Oil well/Gas well How many feet? _____

FROM	TO	PLUGGING MATERIALS	FROM	TO	PLUGGING MATERIALS
55	79.2	Sand			
12	55	Clay - Water settled			*Rock was caved into the well.
11	12	Bentonite			
5	11	Rock from well with Clay			
4.5	5	Bentonite			
0	4.5	Clay - Water settled			

7 CONTRACTOR'S OR LANDOWNER'S CERTIFICATION: This water well was plugged under my jurisdiction and was completed on (mo/day/year) 2/23/2021 and this record is true to the best of my knowledge and belief. Kansas Water Well Contractor's License No. 527. This Water Well Record was completed on (mo/day/year) 3/2/2021 under the business name of GeoCore, LLC by (signature) Dave Kelly

Send one white copy to Kansas Department of Health & Environment, Geology Section, 1000 SW Jackson Street, Ste. 420, Topeka, KS 66612-1367. Send one copy to WATER WELL OWNER and retain one for your records.
 Visit us at <http://www.kdheks.gov/waterwell/index.html> Telephone 785-296-5524.