


1 LOCATION OF WATER WELL: Fraction NW 1/4 SW 1/4 SW 1/4 Section Number 10 Township Number T 10 S Range Number R 2

Distance and direction from nearest town or city street address of well if located within city?
 3 1/4 Mile North of Wells, KS

2 WATER WELL OWNER: Steve Jost
 RR#, St. Address, Box #: R.R. Board of Agriculture, Division of Water Resources
 City, State, ZIP Code: Wells, KS 67488 Application Number:

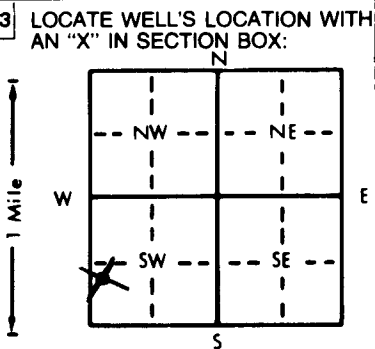

4 DEPTH OF COMPLETED WELL... 90 ft. ELEVATION: ...
 Depth(s) Groundwater Encountered 1... 57 ft. 2... ft. 3... ft.
 WELL'S STATIC WATER LEVEL... 57 ft. below land surface measured on mo/day/yr 11-7-94
 Pump test data: Well water was ... ft. after ... hours pumping ... gpm
 Est. Yield... 10 gpm: Well water was ... ft. after ... hours pumping ... gpm
 Bore Hole Diameter... 8 in. to 90 ft., and ... in. to ... ft.
 WELL WATER TO BE USED AS: 5 Public water supply 8 Air conditioning 11 Injection well
 1 Domestic 3 Feedlot 6 Oil field water supply 9 Dewatering 12 Other (Specify below)
 2 Irrigation 4 Industrial 7 Lawn and garden only 10 Monitoring well
 Was a chemical/bacteriological sample submitted to Department? Yes... No... X...; If yes, mo/day/yr sample was submitted
 Water Well Disinfected? Yes X No

5 TYPE OF BLANK CASING USED: 5 Wrought iron 8 Concrete tile CASING JOINTS: Glued X Clamped
 1 Steel 3 RMP (SR) 6 Asbestos-Cement 9 Other (specify below) Welded
 2 PVC 4 ABS 7 Fiberglass Threaded
 Blank casing diameter... 5 in. to 70 ft., Dia... in. to ... ft., Dia... in. to ... ft.
 Casing height above land surface... 12 in., weight... 2.37 lbs./ft. Wall thickness or gauge No. 214
 TYPE OF SCREEN OR PERFORATION MATERIAL: 7 PVC 10 Asbestos-cement
 1 Steel 3 Stainless steel 5 Fiberglass 8 RMP (SR) 11 Other (specify)
 2 Brass 4 Galvanized steel 6 Concrete tile 9 ABS 12 None used (open hole)
 SCREEN OR PERFORATION OPENINGS ARE: 5 Gauzed wrapped 8 Saw cut 11 None (open hole)
 1 Continuous slot 3 Mill slot 6 Wire wrapped 9 Drilled holes
 2 Louvered shutter 4 Key punched 7 Torch cut 10 Other (specify)
 SCREEN-PERFORATED INTERVALS: From 70 ft. to 90 ft., From ... ft. to ... ft.
 GRAVEL PACK INTERVALS: From 25 ft. to 90 ft., From ... ft. to ... ft.

6 GROUT MATERIAL: 1 Neat cement 2 Cement grout 3 Bentonite 4 Other
 Grout Intervals: From 5 ft. to 25 ft., From ... ft. to ... ft.
 What is the nearest source of possible contamination: 10 Livestock pens 14 Abandoned water well
 1 Septic tank 4 Lateral lines 7 Pit privy 11 Fuel storage 15 Oil well/Gas well
 2 Sewer lines 5 Cess pool 8 Sewage lagoon 12 Fertilizer storage 16 Other (specify below)
 3 Watertight sewer lines 6 Seepage pit 9 Feedyard 13 Insecticide storage
 Direction from well? North How many feet? 50ft

FROM	TO	LITHOLOGIC LOG	FROM	TO	PLUGGING INTERVALS
0	1	Top Soil			
1	3	Gray Clay			
3	5	Tan Clay			
5	9	Sand Rock			
9	35	Light Gray Shale			
35	70	Tan Sandstone			
70	75	Brown Sandstone			
75	90	Tan Sandstone			

7 CONTRACTOR'S OR LANDOWNER'S CERTIFICATION: This water well was (1) constructed, (2) reconstructed, or (3) plugged under my jurisdiction and was completed on (mo/day/year) 11-7-94 and this record is true to the best of my knowledge and belief. Kansas Water Well Contractor's License No. 138 This Water Well Record was completed on (mo/day/yr) 11-23-94 under the business name of Peterson Irrigation Inc. by (signature) Mike Peterson

OFFICE USE ONLY
T
R
EW
SEC.
1/4
1/4
1/4