


1 LOCATION OF WATER WELL: Fraction WC 1/4 NC 1/4 NE 1/4 1/4 Section Number 3 Township Number T 10 S Range Number R 20 EW
 County: Rooks

Distance and direction from nearest town or city street address of well if located within city?
Approx. 6 miles SE of Palco Ks. - Plugged old Well

2 WATER WELL OWNER: Leonard Nutsch
 RR#, St. Address, Box #: P.O. Box 8 Board of Agriculture, Division of Water Resources
 City, State, ZIP Code: Palco, Ks. 67657 Application Number:

3 LOCATE WELL'S LOCATION WITH AN "X" IN SECTION BOX: 4 DEPTH OF COMPLETED WELL: 999 ft. ELEVATION: N/A

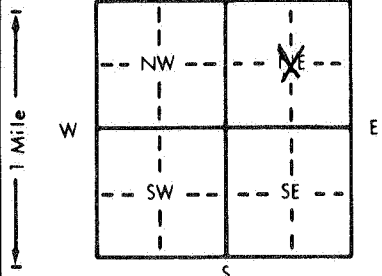

Depth(s) Groundwater Encountered 1. 999 ft. 2. ft. 3. ft.
 WELL'S STATIC WATER LEVEL 33 ft. below land surface measured on mo/day/yr 6-2-96
 NA Pump test data: Well water was ft. after hours pumping gpm
 Est. Yield NA gpm: Well water was ft. after hours pumping gpm
 Bore Hole Diameter: 999 in. to ft. and in. to ft.
 WELL WATER TO BE USED AS: 5 Public water supply 8 Air conditioning 11 Injection well
 ① Domestic 3 Feedlot 6 Oil field water supply 9 Dewatering 12 Other (Specify below)
 2 Irrigation 4 Industrial 7 Lawn and garden only 10 Monitoring well
 Was a chemical/bacteriological sample submitted to Department? Yes.....No; If yes, mo/day/yr sample was submitted Water Well Disinfected? Yes No

5 TYPE OF BLANK CASING USED: 5 Wrought iron 8 Concrete tile CASING JOINTS: Glued Clamped
 1 Steel 3 RMP (SR) 6 Asbestos-Cement 9 Other (specify below) Welded
 2 PVC 4 ABS 7 Fiberglass Galvanized Threaded

Blank casing diameter 5" in. to ft. Dia. in. to ft. Dia. in. to ft.
 Casing height above land surface 7' in. pit in. weight lbs./ft. Wall thickness or gauge No.

TYPE OF SCREEN OR PERFORATION MATERIAL: NA 7 PVC 10 Asbestos-cement
 1 Steel 3 Stainless steel 5 Fiberglass 8 RMP (SR) 11 Other (specify)
 2 Brass 4 Galvanized steel 6 Concrete tile 9 ABS 12 None used (open hole)

SCREEN OR PERFORATION OPENINGS ARE: NA 5 Gauzed wrapped 8 Saw cut 11 None (open hole)
 1 Continuous slot 3 Mill slot 6 Wire wrapped 9 Drilled holes
 2 Louvered shutter 4 Key punched 7 Torch cut 10 Other (specify)

SCREEN-PERFORATED INTERVALS NA From ft. to ft., From ft. to ft.
 From ft. to ft., From ft. to ft.

GRAVEL PACK INTERVALS NA From ft. to ft., From ft. to ft.
 From ft. to ft., From ft. to ft.

6 GROUT MATERIAL: ① Neat cement 2 Cement grout ③ Bentonite 4 Other Used to plug. (See below)
 Grout Intervals: From ft. to ft., From ft. to ft., From ft. to ft.

What is the nearest source of possible contamination:
 1 Septic tank 4 Lateral lines 7 Pit privy ① Livestock pens 14 Abandoned water well
 2 Sewer lines 5 Cess pool 8 Sewage lagoon 11 Fuel storage 15 Oil well/Gas well
 3 Watertight sewer lines 6 Seepage pit 9 Feedyard 12 Fertilizer storage 16 Other (specify below)
 13 Insecticide storage

Direction from well? SW How many feet? 300'

FROM	TO	LITHOLOGIC LOG	FROM	TO	PLUGGING INTERVALS
					<u>Plugged Old Existing Well</u>
					<u>All measurements from</u>
					<u>7' below land surface in pit</u>
			<u>75'</u>	<u>20'</u>	<u>CMA Gravel Pack</u>
			<u>20'</u>	<u>5'</u>	<u>Neat Cement</u>
			<u>5'</u>	<u>1'</u>	<u>50# med chip bentonite</u>
			<u>1'</u>	<u>0'</u>	<u>finished quick Crete</u>

7 CONTRACTOR'S OR LANDOWNER'S CERTIFICATION: This water well was (1) constructed, (2) reconstructed, or (3) plugged under my jurisdiction and was completed on (mo/day/year) 6-2-96 and this record is true to the best of my knowledge and belief. Kansas Water Well Contractor's License No. 608 This Water Well Record was completed on (mo/day/yr) 6-29-96 under the business name of Yellow Jacket Drilling by (signature) Eui T. Woodell