


1 LOCATION OF WATER WELL: Fraction Section Number Township Number Range Number
 County: ROOKS SE 1/4 NW 1/4 SW 1/4 6 10S 20W

Distance and direction from nearest town or city street address of well if located within city?
5 1/2 MILES ON 3RD FROM PALCO, KS, E 1 1/2 MILES ON YRD, S 1/2 MILE INTO SECTION 6

2 WATER WELL OWNER: NATIONAL COOPERATIVE REFINERY ASSOCIATION
 RR #, St. Address, Box #: 1391 IRONHORSE ROAD Board of Agriculture, Division of Water Resources
 City, State, ZIP Code: MC PHERSON, KANSAS 67460 Application Number: _____

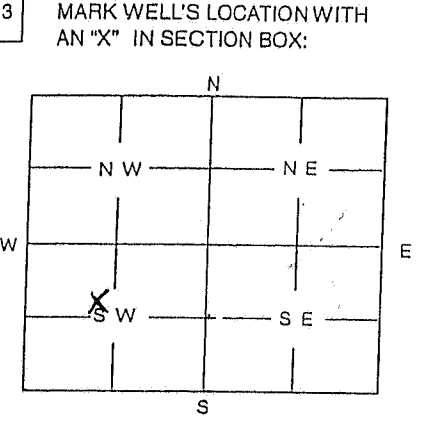

4 DEPTH OF WELL 24.5' ft
 WELL'S STATIC WATER LEVEL 20.5' ft
 WELL WAS USED AS:
 1 Domestic 5 Public Water Supply 9 Dewatering
 2 Irrigation 6 Oil Field Water Supply 10 Monitoring Well
 3 Feedlot 7 Domestic (Lawn & Garden) 11 Injection Well
 4 Industrial 8 Air Conditioning 12 Other _____
 Was a chemical / bacteriological sample submitted to Department? Yes _____ No
 If yes, mo/day/yr sample was submitted _____
 Water Well Disinfected: Yes _____ No

5 TYPE OF BLANK CASING USED:
 1 Steel 3 RMP (SR) 5 Wrought 7 Fiberglass 9 Other (Specify below)
 2 PVC 4 ABS 6 Asbestos-Cement 8 Concrete Tile
 Blank casing diameter 2 in. Was casing pulled? Yes No _____ If yes, how much 24.5'
 Casing height above or below land surface 0 in.

6 GROUT PLUG MATERIAL: 1 Neat cement 2 Cement grout 3 Bentonite 4 Other NATIVE SOIL
 Grout Plug Intervals: From 2 ft. to 24.5 ft., From 0 ft. to 2 ft., From _____ to _____ ft.
 What is the nearest source of possible contamination:
 1 Septic tank 6 Seepage pit 11 Fuel storage 16 Other (specify below)
 2 Sewer lines 7 Pit privy 12 Fertilizer storage UNKNOWN
 3 Watertight sewer lines 8 Sewage lagoon 13 Insecticide storage
 4 Lateral lines 9 Feedyard 14 Abandoned water well
 5 Cess Pool 10 Livestock pens 15 Oil well/Gas well
 Direction from well? _____ How many feet? _____

FROM	TO	PLUGGING MATERIALS
0'	2'	NATIVE SOIL
2'	20'	BENTONITE 8"
20'	24.5'	BENTONITE 2"

KELLER - MW2

7 CONTRACTOR'S OR LANDOWNER'S CERTIFICATION: This water well was plugged under my jurisdiction and was completed on (mo/day/year) 5/21/03 and this record is true to the best of my knowledge and belief. Kansas Water Well Contractor's License No. 527 This Water Well Record was completed on (mo/day/year) 5/29/03 under the business name of GEDCORE, INC. by (signature) Dale P. P.

INSTRUCTIONS: Use typewriter or ball point pen. Please press firmly and print clearly. Please fill in blanks, underline or circle the correct answers. Send top three copies to Kansas Department of Health and Environment, Bureau of Water, Topeka, Kansas 66620-0001. Telephone: 785/296-3565. Send one to Water Well Owner and retain one for your records.