

WATER WELL RECORD Form WWC-5 KSA 82a-1212


1 LOCATION OF WATER WELL: Fraction NE 1/4 NW 1/4 SW 1/4 Section Number 9 Township Number T 10 S Range Number R 20 EW
 County: Rooks

Distance and direction from nearest town or city street address of well if located within city?

1/4 South of Palco, Kansas

2 WATER WELL OWNER: Lee Couture
 RR#, St. Address, Box #: R.R. Board of Agriculture, Division of Water Resources
 City, State, ZIP Code: Plainville, Kansas 67663 Application Number:

3 LOCATE WELL'S LOCATION WITH AN "X" IN SECTION BOX:

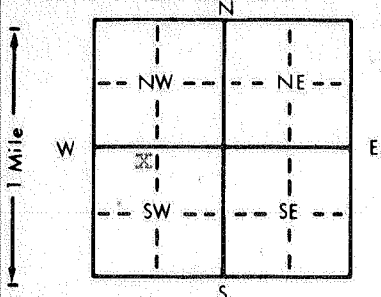

4 DEPTH OF COMPLETED WELL: 44 ft. ELEVATION: Upland

Depth(s) Groundwater Encountered 1. 38 ft. 2. 38 ft. 3. 38 ft.
 WELL'S STATIC WATER LEVEL 28 ft. below land surface measured on April 26, 1983
 Pump test data: Well water was 38 ft. after 1 hours pumping 15 gpm
 Est. Yield 15 gpm: Well water was 38 ft. after 1 hours pumping 15 gpm
 Bore Hole Diameter 9 in. to 44 ft., and 15 in. to 44 ft.

WELL WATER TO BE USED AS: 1 5 Public water supply 8 Air conditioning 11 Injection well
1 Domestic 3 Feedlot 6 Oil field water supply 9 Dewatering 12 Other (Specify below)
2 Irrigation 4 Industrial 7 Lawn and garden only 10 Observation well

Was a chemical/bacteriological sample submitted to Department? Yes X No X; If yes, mo/day/yr sample was submitted 15 Water Well Disinfected? Yes X No X

5 TYPE OF BLANK CASING USED: 2 5 Wrought iron 8 Concrete tile CASING JOINTS: Glued X Clamped X
1 Steel 3 RMP (SR) 6 Asbestos-Cement 9 Other (specify below) Welded X
2 PVC 4 ABS 7 Fiberglass Threaded X

Blank casing diameter 5 in. to 34 ft., Dia 18 in. to 160 in. to 26 ft., Dia 18 in. to 26 ft.
 Casing height above land surface 18 in., weight 160 lbs./ft. Wall thickness or gauge No. 26

TYPE OF SCREEN OR PERFORATION MATERIAL: 7 7 PVC 10 Asbestos-cement
1 Steel 3 Stainless steel 5 Fiberglass 8 RMP (SR) 11 Other (specify) X
2 Brass 4 Galvanized steel 6 Concrete tile 9 ABS 12 None used (open hole)

SCREEN OR PERFORATION OPENINGS ARE: 8 5 Gauzed wrapped 8 Saw cut 11 None (open hole)
1 Continuous slot 3 Mill slot 6 Wire wrapped 9 Drilled holes
2 Louvered shutter 4 Key punched 7 Torch cut 10 Other (specify) X

SCREEN-PERFORATED INTERVALS: From 34 ft. to 44 ft., From 44 ft. to 44 ft.
 GRAVEL PACK INTERVALS: From 14 ft. to 44 ft., From 44 ft. to 44 ft.

6 GROUT MATERIAL: 1 1 Neat cement 2 Cement grout 3 Bentonite 4 Other
 Grout Intervals: From 0 ft. to 10 ft., From 10 ft. to 10 ft., From 10 ft. to 10 ft.

What is the nearest source of possible contamination: NONE
1 Septic tank 4 Lateral lines 7 Pit privy 10 Livestock pens 14 Abandoned water well
2 Sewer lines 5 Cess pool 8 Sewage lagoon 11 Fuel storage 15 Oil well/Gas well
3 Watertight sewer lines 6 Seepage pit 9 Feedyard 12 Fertilizer storage 16 Other (specify below)
 13 Insecticide storage

Direction from well? _____ How many feet? _____

FROM	TO	LITHOLOGIC LOG	FROM	TO	LITHOLOGIC LOG
0	2	Topsoil			
2	12	Brown clay			
12	38	Sand			
38	40	Yellow clay			
40	44	Shale			

7 CONTRACTOR'S OR LANDOWNER'S CERTIFICATION: This water well was (1) constructed, (2) reconstructed, or (3) plugged under my jurisdiction and was completed on (mo/day/year) April 26, 1983 and this record is true to the best of my knowledge and belief. Kansas Water Well Contractor's License No. 199 This Water Well Record was completed on (mo/day/yr) May 13, 1983 under the business name of Karst Water Well Service by signature MB Karst

INSTRUCTIONS: Use typewriter or ball point pen, PLEASE PRESS FIRMLY and PRINT clearly. Please fill in blanks, underline or circle the correct answers. Send top three copies to Kansas Department of Health and Environment, Division of Environment, Environmental Geology Section, Topeka, KS 66620. Send one to WATER WELL OWNER and retain one for your records.