


1 LOCATION OF WATER WELL: County: Rooks Fraction: SW 1/4 NE 1/4 NE 1/4 Section Number: 10 Township Number: T 10 S Range Number: R 20 E/W

Distance and direction from nearest town or city street address of well if located within city?

3 miles South of Quick and 5 1/8 West

2 WATER WELL OWNER: Dwight Sutor RR#, St. Address, Box #: R.R. 1 City, State, ZIP Code: Quick KS Board of Agriculture, Division of Water Resource Application Number:

3 LOCATE WELL'S LOCATION WITH AN "X" IN SECTION BOX:

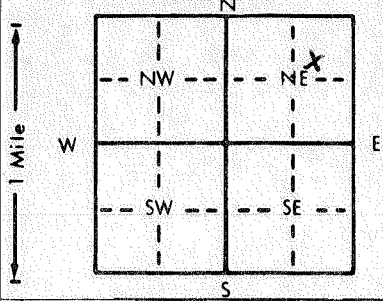

4 DEPTH OF COMPLETED WELL: 66 ft. ELEVATION:

Depth(s) Groundwater Encountered 1. 46 ft. 2. ft. 3. ft.

WELL'S STATIC WATER LEVEL: 32 ft. below land surface measured on mo/day/yr 5/21/85

Pump test data: Well water was ft. after hours pumping gpm

Est. Yield 20+ gpm: Well water was ft. after hours pumping gpm

Bore Hole Diameter: 10 1/4 in. to 66 ft., and in. to ft.

WELL WATER TO BE USED AS: 5 Public water supply 8 Air conditioning 11 Injection well

1 Domestic 3 Feedlot 6 Oil field water supply 9 Dewatering 12 Other (Specify below)

2 Irrigation 4 Industrial Lawn and garden only 10 Observation well

Was a chemical/bacteriological sample submitted to Department? Yes X No; If yes, mo/day/yr sample was submitted

Water Well Disinfected? Yes X No

5 TYPE OF BLANK CASING USED: 1 Steel 3 RMP (SR) 5 Wrought iron 8 Concrete tile CASING JOINTS: Glued X Clamped

2 PVC 4 ABS 6 Asbestos-Cement 9 Other (specify below) Welded

Blank casing diameter 5.56 in. to 46 ft., Dia. in. to ft., Dia. in. to ft.

Casing height above land surface: 18 inches in., weight lbs./ft. Wall thickness or gauge No SAR-26

TYPE OF SCREEN OR PERFORATION MATERIAL: 1 Steel 3 Stainless steel 5 Fiberglass 8 RMP (SR) 10 Asbestos-cement

2 Brass 4 Galvanized steel 6 Concrete tile 9 ABS 11 Other (specify)

SCREEN OR PERFORATION OPENINGS ARE: 1 Continuous slot 3 Mill slot 5 Gauzed wrapped 8 Saw cut 11 None (open hole)

2 Louvered shutter 4 Key punched 6 Wire wrapped 9 Drilled holes

SCREEN-PERFORATED INTERVALS: From 66 ft. to 46 ft., From ft. to ft., From ft. to ft.

GRAVEL PACK INTERVALS: From 66 ft. to 35 ft., From ft. to ft., From ft. to ft.

6 GROUT MATERIAL: 1 Neat cement 2 Cement grout 3 Bentonite 4 Other

Grout Intervals: From 10 ft. to 0 ft., From ft. to ft., From ft. to ft., From ft. to ft.

What is the nearest source of possible contamination: 10 Livestock pens 14 Abandoned water well

1 Septic tank 4 Lateral lines 7 Pit privy 11 Fuel storage 15 Oil well/Gas well

2 Sewer lines 5 Cess pool 8 Sewage lagoon 12 Fertilizer storage 16 Other (specify below)

3 Watertight sewer lines 6 Seepage pit 9 Feedyard 13 Insecticide storage

Direction from well? South How many feet? 200 ft

FROM	TO	LITHOLOGIC LOG	FROM	TO	LITHOLOGIC LOG
0	6	Top soil			
6	13	fine sand			
13	36	medium to coarse sand (dry)			
36	43	medium to coarse sand w/ some clay			
43	46	limestone rock bedrock			
46	56	good coarse sand			
56	58	limestone rock			
58	63	medium to coarse sand			
63	66	shale			

7 CONTRACTOR'S OR LANDOWNER'S CERTIFICATION: This water well was (1) constructed, (2) reconstructed, or (3) plugged under my jurisdiction and was completed on (mo/day/year) 5/21/85 and this record is true to the best of my knowledge and belief. Kansas Water Well Contractor's License No. 455 This Water Well Record was completed on (mo/day/yr) 6/19/85 under the business name of Trans Pump & Supply by (signature) James Baker

INSTRUCTIONS: Use typewriter or ball point pen, PLEASE PRESS FIRMLY and PRINT clearly. Please fill in blanks, underline or circle the correct answers. Send top three copies to Kansas Department of Health and Environment, Division of Environment, Environmental Geology Section, Topeka, KS 66620. Send one to WATER WELL OWNER and retain one for your records.