

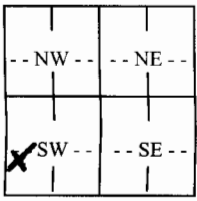
**WATER WELL RECORD**

**Form WWC-5**

Division of Water Resources; App. No. 645

<b>1 LOCATION OF WATER WELL:</b> County: <u>Graham</u>	Fraction <u>NW</u> <sub>4</sub> <u>SW</u> <u>1/4</u> <u>SW</u> <u>1/4</u>	Section Number <u>10</u>	Township Number <u>T 10</u> <u>S</u>	Range Number <u>R 21</u> <u>W</u>
Distance and direction from nearest town or city street address of well if located within city? <u>3 South, 4 1/2 west of Palco, KS</u>		<b>Global Positioning Systems</b> (decimal degrees, min. of 4 digits) Latitude: _____ Longitude: _____ Elevation: _____ Datum: _____ Data Collection Method: _____		

**2 WATER WELL OWNER:** Carl Acheson  
RR#, St. Address, Box # : 3748 C. Road  
City, State, ZIP Code : Palco, KS 67657

<b>3 LOCATE WELL'S LOCATION WITH AN "X" IN SECTION BOX:</b> N  W E S	<b>4 DEPTH OF COMPLETED WELL</b> ..... <u>20</u> ..... ft. Depth(s) Groundwater Encountered (1)..... ft. (2)..... ft. (3)..... ft. WELL'S STATIC WATER LEVEL..... <u>10</u> ..... ft. below land surface measured on <u>mo/day/yr. 9/1/05</u> ..... Pump test data: Well water was.....ft. after..... hours pumping..... gpm Est. Yield.....gpm: Well water was.....ft. after..... hours pumping..... gpm WELL WATER TO BE USED AS: <u>5</u> Public water supply <u>8</u> Air conditioning <u>11</u> Injection well <u>1</u> Domestic <u>3</u> Feedlot <u>6</u> Oil field water supply <u>9</u> Dewatering <u>12</u> Other (Specify below) <u>2</u> Irrigation <u>4</u> Industrial <u>7</u> Domestic (lawn & garden) <u>10</u> Monitoring well Was a chemical/bacteriological sample submitted to Department? Yes ..... No .. <u>X</u> ....; If yes, mo/day/yr Sample was submitted..... Water well disinfected? Yes .. <u>X</u> .... No .....
---	--

**5 TYPE OF CASING USED:**    5 Wrought Iron    8 Concrete tile    CASING JOINTS: Glued..... Clamped.....  
1 Steel    3 RMP (SR)    6 Asbestos-Cement    9 Other (specify below)    Welded.....  
2 PVC    4 ABS    7 Fiberglass    .....    Threaded.....

Blank casing diameter .....4..... in. to ..... ft., Diameter ..... in. to ..... ft., Diameter ..... in. to ..... ft.  
Casing height above land surface..... in., weight.....lbs./ft.    Wall thickness or gauge No. ....

**TYPE OF SCREEN OR PERFORATION MATERIAL:**  
1 Steel    3 Stainless Steel    5 Fiberglass    7 PVC    9 ABS    11 Other (Specify) .....  
2 Brass    4 Galvanized Steel    6 Concrete tile    8 RM (SR)    10 Asbestos-Cement    12 None used (open hole)

**SCREEN OR PERFORATION OPENINGS ARE:**  
1 Continuous slot    3 Mill slot    5 Gauzed wrapped    7 Torch cut    9 Drilled holes    11 None (open hole)  
2 Louvered shutter    4 Key punched    6 Wire wrapped    8 Saw Cut    10 Other (specify) .....

**SCREEN-PERFORATED INTERVALS:** From..... ft. to ..... ft., From ..... ft. to ..... ft.  
From..... ft. to ..... ft., From ..... ft. to ..... ft.

**GRAVEL PACK INTERVALS:** From..... ft. to ..... ft., From ..... ft. to ..... ft.  
From..... ft. to ..... ft., From ..... ft. to ..... ft.

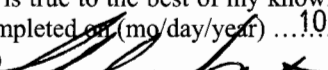
**6 GROUT MATERIAL:**    1 Neat cement    2 Cement grout    3 Bentonite    4 Other .....

Grout Intervals:    From ..... ft. to ..... ft., From ..... ft. to ..... ft., From ..... ft. to ..... ft.

What is the nearest source of possible contamination:  
1 Septic tank    4 Lateral lines    7 Pit privy    10 Livestock pens    13 Insecticide Storage    16 Other (specify below)  
2 Sewer lines    5 Cess pool    8 Sewage lagoon    11 Fuel storage    14 Abandoned water well  
3 Watertight sewer lines    6 Seepage pit    9 Feedyard    12 Fertilizer Storage    15 Oil wll/gas well .....

Direction from well? ..... How many feet? .....

FROM	TO	LITHOLOGIC LOG	FROM	TO	PLUGGING INTERVALS
			<u>0</u>	<u>20</u>	<u>Expanding Bentonite Seal</u>

**7 CONTRACTOR'S OR LANDOWNER'S CERTIFICATION:** This water well was (1) constructed, (2) reconstructed, or (3) plugged under my jurisdiction and was completed on (mo/day/year) ..9/22/05..... and this record is true to the best of my knowledge and belief. Kansas Water Well Contractor's License No. ....199.... This Water Well Recored was completed on (mo/day/year) ...10/12/05..... Under the business name of Karst Water Well Drilling & Service, Inc (signature) 

INSTRUCTIONS: Use typewriter or ball point pen. PLEASE PRESS FIRMLY and PRINT clearly. Please fill in blanks, underline or circle the correct answers. Send top three copies to Kansas Department of Health and Environment, Bureau of Water, Geology Section, 1000 SW Jackson St., Suite 420, Topeka, Kansas 66612-1367. Telephone 785-296-5522. Send one to WATER WELL OWNER and retain one for your records. Fee of \$5.00 for each constructed well.