


1 LOCATION OF WATER WELL: County: Graham Fraction: NE 1/4 AC 1/4 NE 1/4 Section Number: NE 7 28 Township Number: T 10 S Range Number: R 22 EW

Distance and direction from nearest town or city street address of well if located within city? 8 1/2 N, SE Wakeeney 52 52 NE

2 WATER WELL OWNER: Dave Faulkner
 RR#, St. Address, Box #: RR #1
 City, State, ZIP Code: Ogallah KS
 Board of Agriculture, Division of Water Resources
 Application Number:

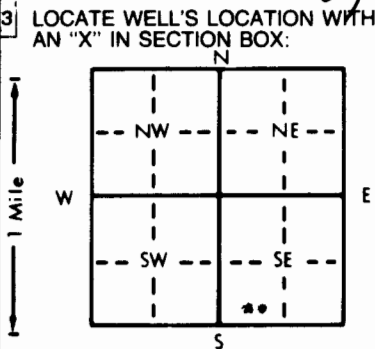

4 DEPTH OF COMPLETED WELL: 11' ft. ELEVATION: ft.
 Depth(s) Groundwater Encountered 1. 9' ft. 2. ft. 3. ft.
 WELL'S STATIC WATER LEVEL: 9' ft. below land surface measured on mo/day/yr 10-19-96
 Pump test data: Well water was ft. after hours pumping gpm
 Est. Yield gpm: Well water was ft. after hours pumping gpm
 Bore Hole Diameter: in. to ft., and in. to ft.
 WELL WATER TO BE USED AS:
 1 Domestic 3 Feedlot 6 Oil field water supply 9 Dewatering 12 Other (Specify below)
 2 Irrigation 4 Industrial 7 Lawn and garden only 10 Monitoring well
 Was a chemical/bacteriological sample submitted to Department? Yes.....No.....; If yes, mo/day/yr sample was submitted
 Water Well Disinfected? Yes No

5 TYPE OF BLANK CASING USED:
 1 Steel 3 RMP (SR) 5 Wrought iron 8 Concrete tile CASING JOINTS: Glued Clamped
 2 PVC 4 ABS 7 Fiberglass Welded
 3 Stainless steel 6 Asbestos-Cement 9 Other (specify below) Threaded
 Blank casing diameter: 5 1/2" in. to ft., Dia in. to ft., Dia in. to ft.
 Casing height above land surface: 1' in., weight lbs./ft. Wall thickness or gauge No. 18ga
 TYPE OF SCREEN OR PERFORATION MATERIAL:
 1 Steel 3 Stainless steel 5 Fiberglass 8 RMP (SR) 10 Asbestos-cement
 2 Brass 4 Galvanized steel 6 Concrete tile 9 ABS 11 Other (specify)
 12 None used (open hole)
 SCREEN OR PERFORATION OPENINGS ARE:
 1 Continuous slot 3 Mill slot 5 Gauzed wrapped 8 Saw cut 11 None (open hole)
 2 Louvered shutter 4 Key punched 6 Wire wrapped 9 Drilled holes
 7 Torch cut 10 Other (specify)
 SCREEN-PERFORATED INTERVALS: From ft. to ft., From ft. to ft.
 GRAVEL PACK INTERVALS: From ft. to ft., From ft. to ft.

6 GROUT MATERIAL: 1 Neat cement 2 Cement grout 3 Bentonite 4 Other
 Grout Intervals: From ft. to ft., From ft. to ft.
 What is the nearest source of possible contamination:
 1 Septic tank 4 Lateral lines 7 Pit privy 10 Livestock pens 14 Abandoned water well
 2 Sewer lines 5 Cess pool 8 Sewage lagoon 11 Fuel storage 15 Oil well/Gas well
 3 Watertight sewer lines 6 Seepage pit 9 Feedyard 12 Fertilizer storage 16 Other (specify below)
 Direction from well? How many feet?

FROM	TO	LITHOLOGIC LOG	FROM	TO	PLUGGING INTERVALS
0	3	Topsoil - Compacted			
3	6	Bentonite			
6	9	Compacted Subsoil			
9	11	Disinfected Sand			

7 CONTRACTOR'S OR LANDOWNER'S CERTIFICATION: This water well was (1) constructed, (2) reconstructed, or plugged under my jurisdiction and was completed on (mo/day/year) 10-19-96 and this record is true to the best of my knowledge and belief. Kansas Water Well Contractor's License No. none This Water Well Record was completed on (mo/day/yr) 10-19-96 under the business name of none by (signature) Dave Faulkner

OFFICE USE ONLY
T
R
EW
SEC.
1/4
1/4
1/4