

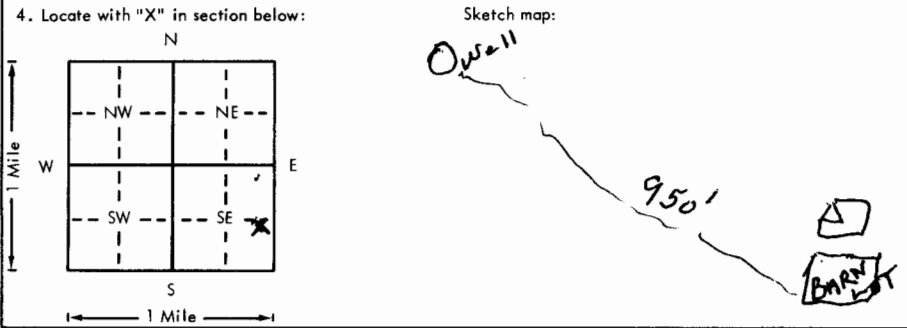
ACCEN

TOGO

USE TYPEWRITER OR BALL POINT PEN-PRESS FIRMLY, PRINT CLEARLY.

WATER WELL RECORD
KSA 82a-1201-1215

Kansas Department of Health and Environment-Division of Environment
(Water well Contractors)
Topeka, Kansas 66620

1. Location of well: County GRAHAM Fraction NE 1/4 NE 1/4 SE 1/4 Section number 6 Township number T 10 S R 22 E NW Range number	
2. Distance and direction from nearest town or city: 10 1/2 miles South 2 1/2 miles East of Hill City, KS. 3. Owner of well: Wilbur Stites RFD #1. R.R. or street: WAKEENEY, KS, 67672 City, state, zip code:	
4. Locate with "X" in section below: Sketch map: 	
5. Type and color of material	
	From To
CLAY	0 18
SAND	18 34
COARSE SAND	34 38
CLAY TO SHALE	38 45
BROCK ?	39' to 70' thick
	19' sat thick
	OG
(Use a second sheet if needed)	
18. Elevation: Topography: <input checked="" type="checkbox"/> Hill <input checked="" type="checkbox"/> Slope <input type="checkbox"/> Upland <input type="checkbox"/> Valley	19. Remarks: CUSTOMER TO INSTALL CEMENT SLAB AT ground level ET 2330 Topo Tm 2291
6. Bore hole dia. 9 in. Completion date 5/4/79 Well depth 38 1/2 ft.	
7. <input type="checkbox"/> Cable tool <input checked="" type="checkbox"/> Rotary <input type="checkbox"/> Driven <input type="checkbox"/> Dug <input type="checkbox"/> Hollow rod <input type="checkbox"/> Jetted <input type="checkbox"/> Bored <input type="checkbox"/> Reverse rotary	
8. Use: <input checked="" type="checkbox"/> Domestic <input type="checkbox"/> Public supply <input type="checkbox"/> Industry <input type="checkbox"/> Irrigation <input type="checkbox"/> Air conditioning <input type="checkbox"/> Stock <input type="checkbox"/> Lawn <input type="checkbox"/> Oil field water <input type="checkbox"/> Other	
9. Casing: Material PLASTIC Height: Above or below Threading gildred Surface 24 in. RMP <input type="checkbox"/> PVC <input checked="" type="checkbox"/> Weight <input type="checkbox"/> lbs./ft. Dia. 5 in. to 45 ft. depth Wall Thickness: inches or Dia. <input type="checkbox"/> in. to <input type="checkbox"/> ft. depth gage No. 250	
10. Screens: Manufacturer's name Free-Flow W.A. Brown Ent. Type PLASTIC Dia. 5" Slot/gauze 1/16 Length 10' Set between .35 ft. and 45 ft. Gravel pack? yes Size range of material 4-5/8"	
11. Static water level: 20 ft. below land surface Date 5/4/79 mo./day/yr.	
12. Pumping level below land surfaces: NOT DONE ft. after <input type="checkbox"/> hrs. pumping <input type="checkbox"/> g.p.m. Estimated maximum yield <input type="checkbox"/> g.p.m.	
13. Water sample submitted: <input type="checkbox"/> Yes <input checked="" type="checkbox"/> No Date <input type="checkbox"/> mo./day/yr.	
14. Well head completion: NOT DONE Pitless adapter <input type="checkbox"/> inches above grade	
<input checked="" type="checkbox"/> Well grouted? yes With: <input checked="" type="checkbox"/> Neat cement <input type="checkbox"/> Bentonite <input type="checkbox"/> Concrete Depth: From 0 ft. to 10 ft.	
16. Nearest source of possible contamination: 925 ft. Direction S.E. Type BARN LOT Well disinfected upon completion? <input checked="" type="checkbox"/> Yes <input type="checkbox"/> No	
17. Pump: <input checked="" type="checkbox"/> Not installed Manufacturer's name <input type="checkbox"/> Model number <input type="checkbox"/> HP <input type="checkbox"/> Volts Length of drop pipe <input type="checkbox"/> ft. capacity <input type="checkbox"/> g.p.m. Type: <input type="checkbox"/> Submersible <input type="checkbox"/> Turbine <input type="checkbox"/> Jet <input type="checkbox"/> Reciprocating <input type="checkbox"/> Centrifugal <input type="checkbox"/> Other	
20. Water well contractor's certification: This well was drilled under my jurisdiction and this report is true to the best of my knowledge and belief. DEL DRILLING Co 303 Business name License No. Box 368 Hill City, KS 67672 Address Signed Arthur Francis Date 5/23/79 Authorized representative	

10 220 10 NE 1/4

Forward the white, blue and pink copies to the Department of Health and Environment

Form WWC-5