

WATER WELL RECORD

Form WWC-5


Division of Water Resources App. No.

[Empty box]

1 LOCATION OF WATER WELL: County: Graham Fraction SW 1/4 SW 1/4 SW 1/4 SW 1/4 Section Number 9 Township No. T 10 S Range Number R 24 E W

Street/Rural Address of Well Location; if unknown, distance & direction from nearest town or intersection: If at owner's address, check here [X] 4 East of St. Peter Global Positioning System (GPS) information: Latitude: Longitude: Elevation: Datum: Collection Method: Est. Accuracy:

2 WATER WELL OWNER: RR#, Street Address, Box #: Tony Herman 1908 E Rd Penokee KS 67659 City, State, ZIP Code

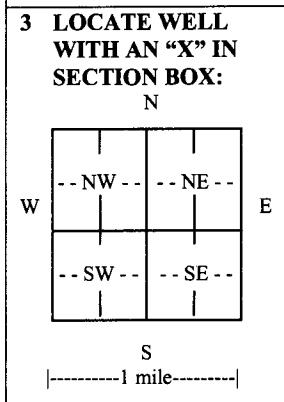

3 LOCATE WELL WITH AN 'X' IN SECTION BOX: N E W S 4 DEPTH OF COMPLETED WELL 118 ft. Depth(s) Groundwater Encountered (1) 56 ft. (2) ft. (3) ft. WELL'S STATIC WATER LEVEL 56 ft. below land surface measured on mo/day/yr 8-21-12 Pump test data: Well water was...ft. after... hours pumping... gpm EST. YIELD 10 gpm. Well water was...ft. after... hours pumping... gpm Bore Hole Diameter 9 in. to...ft., and...in. to...ft. WELL WATER TO BE USED AS: [X] Domestic [X] Irrigation [X] Livestock [] Public water supply [] Geothermal [] Injection well [] Dewatering [] Other (Specify below) [] Oil field water supply [] Monitoring well [] Industrial [] Domestic-lawn & garden [] Yes [X] No Was a chemical/bacteriological sample submitted to Department? If yes, mo/day/yr sample was submitted. Water well disinfected? [X] Yes [] No

5 TYPE OF CASING USED: [X] PVC [] Steel [] Other CASING JOINTS: [X] Glued [] Clamped [] Welded [] Threaded Casing diameter 5 in. to...ft., Diameter...in. to...ft., Diameter...in. to...ft. Casing height above land surface 30 in., Weight...lbs./ft., Wall thickness or gauge No. TYPE OF SCREEN OR PERFORATION MATERIAL: [X] PVC [] Steel [] Stainless Steel [] Brass [] Galvanized Steel [] None used (open hole) [] Other (Specify) SCREEN OR PERFORATION OPENINGS ARE: [X] Continuous slot [] Mill slot [] Gauze wrapped [] Torch cut [] Drilled holes [] None (open hole) [] Louvered shutter [] Key punched [] Wire wrapped [] Saw cut [] Other (specify) SCREEN-PERFORATED INTERVALS: From 118 ft. to 98 ft., From...ft. to...ft. GRAVEL PACK INTERVALS: From 118 ft. to 20 ft., From...ft. to...ft.

6 GROUT MATERIAL: [X] Bentonite [] Neat cement [] Cement grout [] Other Grout Intervals: From 20 ft. to 0 ft., From...ft. to...ft., From...ft. to...ft. What is the nearest source of possible contamination: [X] Livestock pens [] Septic tank [] Sewer lines [] Watertight sewer lines [] Lateral lines [] Cesspool [] Seepage pit [] Pit privy [] Sewage lagoon [] Feedyard [] Fuel storage [] Fertilizer storage [] Insecticide storage [] Abandoned water well [] Oil well/gas well [] Other (specify below) Direction from well... Distance from well 30 ft.

Table with columns: FROM, TO, LITHOLOGIC LOG, FROM, TO, LITHO. LOG (cont.) or PLUGGING INTERVALS. Rows: 0-16 soil, 16-25 sandstone, 25-58 gravel, 58-77 limestone, 77-118 clay & sand.

7 CONTRACTOR'S OR LANDOWNER'S CERTIFICATION: This water well was [X] constructed, [] reconstructed, or [] plugged under my jurisdiction and was completed on (mo/day/year) 8-21-12 and this record is true to the best of my knowledge and belief. Kansas Water Well Contractor's License No. 800. This Water Well Record was completed on (mo/day/year) 8-25-12 under the business name of Gottschalk Well Drilling (signature) Terry Gottschalk

INSTRUCTIONS: Use typewriter or ball point pen. PLEASE PRESS FIRMLY and PRINT clearly. Please fill in blanks and check the correct answers. Send three copies (white, blue, pink) to Kansas Department of Health and Environment, Bureau of Water, Geology Section, 1000 SW Jackson St., Suite 420, Topeka, Kansas 66612-1367. Telephone 785-296-5524. Send one copy to WATER WELL OWNER and retain one for your records. Include fee of \$5.00 for each constructed well. Visit us at http://www.kdheks.gov/waterwell/index.html.