


1 LOCATION OF WATER WELL: Fraction NW 1/4 NW 1/4 NW 1/4 Section Number 19 Township Number T 10 S Range Number R 25 EW  
 County: Shannon

Distance and direction from nearest town or city street address of well if located within city?  
in the City of St. Pelly, Kansas

2 WATER WELL OWNER: Robert P. Fisher  
 RR#, St. Address, Box #: Rt 1 Morland Kansas 67650 Board of Agriculture, Division of Water Resources  
 City, State, ZIP Code: Morland Kansas 67650 Application Number:

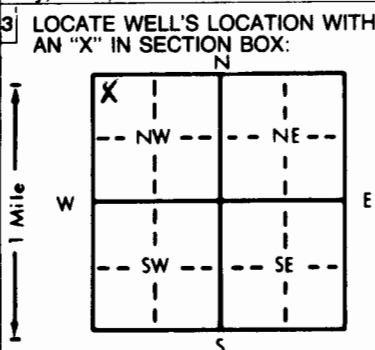

4 DEPTH OF COMPLETED WELL: 74 ft. ELEVATION: .....  
 Depth(s) Groundwater Encountered 1. 64 ft. 2. .... ft. 3. .... ft.  
 WELL'S STATIC WATER LEVEL: 64 ft. below land surface measured on mo/day/yr 8-4-91  
 Pump test data: Well water was 64 ft. after 2 hours pumping 12 gpm  
 Est. Yield 15 gpm: Well water was ..... ft. after ..... hours pumping ..... gpm  
 Bore Hole Diameter: 1.0 in. to ..... ft., and ..... in. to ..... ft.  
 WELL WATER TO BE USED AS:  
 Domestic  3 Feedlot  6 Oil field water supply  9 Dewatering  12 Other (Specify below)  
 2 Irrigation  4 Industrial  7 Lawn and garden only  10 Monitoring well  
 Was a chemical/bacteriological sample submitted to Department? Yes..... No  If yes, mo/day/yr sample was submitted  
 Water Well Disinfected? Yes..... No

5 TYPE OF BLANK CASING USED:  
 1 Steel  3 RMP (SR)  6 Asbestos-Cement  9 Other (specify below)  8 Concrete tile CASING JOINTS: Glued  Clamped  
 2 PVC  4 ABS  7 Fiberglass ..... Threaded.....  
 Blank casing diameter: 5 1/2 in. to 5 1/4 ft., Dia ..... in. to ..... ft., Dia ..... in. to ..... ft.  
 Casing height above land surface: 20 in., weight 160 lbs./ft. Wall thickness or gauge No. ....  
 TYPE OF SCREEN OR PERFORATION MATERIAL:  
 1 Steel  3 Stainless steel  5 Fiberglass  8 RMP (SR)  10 Asbestos-cement  
 2 Brass  4 Galvanized steel  6 Concrete tile  9 ABS  12 None used (open hole)  
 SCREEN OR PERFORATION OPENINGS ARE:  
 1 Continuous slot  3 Mill slot  5 Gauzed wrapped  8 Saw cut  11 None (open hole)  
 2 Louvered shutter  4 Key punched  6 Wire wrapped  9 Drilled holes  
 7 Torch cut  10 Other (specify) .....  
 SCREEN-PERFORATED INTERVALS: From 54 ft. to 74 ft., From ..... ft. to ..... ft.  
 From ..... ft. to ..... ft., From ..... ft. to ..... ft.  
 GRAVEL PACK INTERVALS: From 20 ft. to 74 ft., From ..... ft. to ..... ft.  
 From ..... ft. to ..... ft., From ..... ft. to ..... ft.

6 GROUT MATERIAL:  1 Neat cement  2 Cement grout  3 Bentonite  4 Other .....  
 Grout intervals: From 0 ft. to 20 ft., From ..... ft. to ..... ft., From ..... ft. to ..... ft.  
 What is the nearest source of possible contamination:  
 1 Septic tank  4 Lateral lines  7 Pit privy  10 Livestock pens  14 Abandoned water well  
 2 Sewer lines  5 Cess pool  8 Sewage lagoon  11 Fuel storage  15 Oil well/Gas well  
 3 Watertight sewer lines  6 Seepage pit  9 Feedyard  12 Fertilizer storage  16 Other (specify below)  
 13 Insecticide storage .....  
 Direction from well? North How many feet? 20 feet

FROM	TO	LITHOLOGIC LOG	FROM	TO	PLUGGING INTERVALS
0	12	Surface Clay			
12	20	Fine sand			
20	35	med sand			
35	50	Hard Clay			
50	55	Hard Shale Rock			
55	65	med sand			
65	67	flint rock			
67	74	med sand			

7 CONTRACTOR'S OR LANDOWNER'S CERTIFICATION: This water well was (1) constructed, (2) reconstructed, or (3) plugged under my jurisdiction and was completed on (mo/day/year) 8-4-91 and this record is true to the best of my knowledge and belief. Kansas  
 Water Well Contractor's License No. 444 This Water Well Record was completed on (mo/day/yr) 8-4-91  
 under the business name of Anderson Drilling by (signature) Andy Anderson

OFFICE USE ONLY