


1 LOCATION OF WATER WELL:	Fraction	Section Number	Township Number	Range Number
County: <b>Wyandotte</b>	<b>NE ¼ SW ¼ NW ¼</b>	<b>35</b>	<b>T 10 S</b>	<b>R 25 W</b>

Distance and direction from nearest town or city street address of well if located within city?  
**401 E. Donovan Rd, Kansas City**

2 WATER WELL OWNER: **Magellan Midstream Partners, LP**  
 RR#, St. Address, Box # : **One Williams Center Mail Drop 30-7** Board of Agriculture, Division of Water Resources  
 City, State, ZIP Code : **Tulsa, OK 74172** Application Number: \_\_\_\_\_

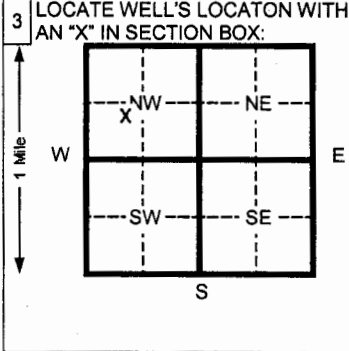

4 DEPTH OF COMPLETED WELL **40** ft. ELEVATION: \_\_\_\_\_  
 Depth(s) Groundwater Encountered 1 **25.5** ft. 2 \_\_\_\_\_ ft. 3 \_\_\_\_\_ ft.  
 WELL'S STATIC WATER LEVEL \_\_\_\_\_ ft. below land surface measured on mo/day/yr  
 Pump test data: Well water was \_\_\_\_\_ ft. after \_\_\_\_\_ hours pumping \_\_\_\_\_ gpm  
 Est. Yield \_\_\_\_\_ gpm: Well water was \_\_\_\_\_ ft. after \_\_\_\_\_ hours pumping \_\_\_\_\_ gpm  
 Bore Hole Diameter **12** in. to **40** ft. and \_\_\_\_\_ in. to \_\_\_\_\_ ft.  
 WELL WATER TO BE USED AS: 5 Public water supply 8 Air conditioning 11 Injection well  
 1 Domestic 3 Feed lot 6 Oil field water supply 9 Dewatering **12** Other (Specify below)  
 2 Irrigation 4 Industrial 7 Lawn and garden (domestic) 10 Monitoring well **Recovery Well**  
 Was a chemical/bacteriological sample submitted to Department? Yes \_\_\_\_\_ No **X** If yes, mo/day/yr sample was submitted \_\_\_\_\_  
 Water Well Disinfected? Yes \_\_\_\_\_ No **X**

5 TYPE OF BLANK CASING USED:

1 Steel	3 RMP (SR)	5 Wrought Iron	8 Concrete tile	CASING JOINTS: Glued _____ Clamped _____
<b>2 PVC</b>	4 ABS	6 Asbestos-Cement	9 Other (specify below) _____	Welded _____
		7 Fiberglass		<b>Threaded Flush</b>

Blank casing diameter **6** in. to **10** ft. Dia \_\_\_\_\_ in. to \_\_\_\_\_ ft. Dia \_\_\_\_\_ in. to \_\_\_\_\_ ft.  
 Casing height above land surface **Flushmount** in., weight **0.703** lbs./ft. Wall thickness or gauge No. **SCH. 40**  
 TYPE OF SCREEN OR PERFORATION MATERIAL: **7 PVC** 10 Asbestos-cement  
 1 Steel 3 Stainless steel 5 Fiberglass 8 RMP (SR) 11 Other (specify) \_\_\_\_\_  
 2 Brass 4 Galvanized steel 6 Concrete tile 9 ABS 12 None used (open hole)  
 SCREEN OR PERFORATION OPENINGS ARE: 5 Gauzed wrapped 8 Saw cut 11 None (open hole)  
 1 Continuous slot **3 Mill slot** 6 Wire wrapped 9 Drilled holes  
 2 Louvered shutter 4 Key punched 7 Torch cut 10 Other (specify) \_\_\_\_\_  
 SCREEN-PERFORATED INTERVALS: From **10** ft. to **40** ft. From \_\_\_\_\_ ft. to \_\_\_\_\_ ft.  
 From \_\_\_\_\_ ft. to \_\_\_\_\_ ft. From \_\_\_\_\_ ft. to \_\_\_\_\_ ft.  
 GRAVEL PACK INTERVALS: From **8** ft. to **40** ft. From \_\_\_\_\_ ft. to \_\_\_\_\_ ft.  
 From \_\_\_\_\_ ft. to \_\_\_\_\_ ft. From \_\_\_\_\_ ft. to \_\_\_\_\_ ft.

6 GROUT MATERIAL: 1 Neat cement **2 Cement grout** **3 Bentonite** 4 Other \_\_\_\_\_  
 Grout Intervals From **2** ft. to **6** ft. From **6** ft. to **8** ft. From \_\_\_\_\_ ft. to \_\_\_\_\_ ft.  
 What is the nearest source of possible contamination:  
 1 Septic tank 4 Lateral lines 7 Pit privy 10 Livestock pens 14 Abandoned water well  
 2 Sewer lines 5 Cess pool 8 Sewage lagoon 11 Fuel storage 15 Oil well/ Gas well  
 3 Watertight sewer lines 6 Seepage pit 9 Feedyard 13 Insecticide storage 16 Other (specify below) \_\_\_\_\_

Direction from well? \_\_\_\_\_ How many feet? \_\_\_\_\_

FROM	TO	CODE	LITHOLOGIC LOG	FROM	TO	PLUGGING INTERVALS
0	9		<b>Silty clay fill</b>			
9	14		<b>Sandy clay - brown</b>			
14	19		<b>Sand - very fine grained, with trace clay, dark gray</b>			
19	40		<b>Sand - very fine to fine grained, gray</b>			

7 CONTRACTOR'S OR LANDOWNER'S CERTIFICATION: This water well was **(1) constructed**, (2) reconstructed, or (3) plugged under my jurisdiction and was completed on (mo/day/yr) **02/26/07** and this record is true to the best of my knowledge and belief. Kansas Water Well Contractor's License No. **531** This Water Well Record was completed on (mo/day/yr) **03/22/07** under the business name of **Geotechnical Services Inc.** by (signature) *[Signature]*

INSTRUCTIONS: Please fill in blanks and circle the correct answers. Send three copies to Kansas Department of Health and Environment, Bureau of Water, 1000 S W Jackson St., Ste. 420, Topeka, Kansas 66612-1367. Telephone: 913-296-5545. Send one to WATER WELL OWNER and retain one for your records.