

WATER WELL RECORD Form WWC-5


Original Record Correction Change in Well Use

Division of Water Resources App. No.

Well ID #2

1 LOCATION OF WATER WELL: County: Sheridan	Fraction $\frac{1}{4}$ NE $\frac{1}{4}$ SE $\frac{1}{4}$ NW $\frac{1}{4}$	Section Number 4	Township Number T 10 S	Range Number R 26 <input type="checkbox"/> E <input checked="" type="checkbox"/> W
---	--	----------------------------	----------------------------------	--

2 WELL OWNER: Last Name: Haffner First: Pat Business Address: 7380 E Rd 10S Address: Hoxie State: KS ZIP: 67740	Street or Rural Address where well is located (if unknown, distance and direction from nearest town or intersection): If at owner's address, check here: <input type="checkbox"/> Int. of Rd 110E & 100S-2076' East & 1822' South
--	---

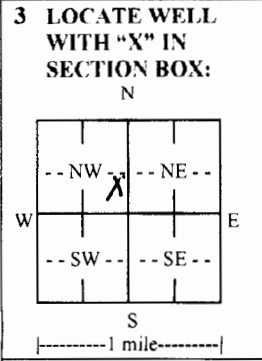

4 DEPTH OF COMPLETED WELL:**116**..... ft.
 Depth(s) Groundwater Encountered: 1) ft.
 2) ft. 3) ft. or 4) Dry Well
WELL'S STATIC WATER LEVEL:**72.5**..... ft.
 below land surface, measured on (mo-day-yr).....**12-2-16**.....
 above land surface, measured on (mo-day-yr).....
 Pump test data: Well water was ft.
 after..... hours pumping gpm
 Well water was ft.
 after..... hours pumping gpm
 Estimated Yield:**25**..... gpm
 Bore Hole Diameter:**11**..... in. to**120**..... ft. and
 in. to ft.

5 Latitude:**39.214058**..... (decimal degrees)
Longitude:**100.231247**..... (decimal degrees)
 Horizontal Datum: WGS 84 NAD 83 NAD 27
 Source for Latitude/Longitude:
 GPS (unit make/model: **Garmin Montana 650T**)
 (WAAS enabled? Yes No)
 Land Survey Topographic Map
 Online Mapper:

6 Elevation:ft. Ground Level TOC
 Source: Land Survey GPS Topographic Map
 Other

7 WELL WATER TO BE USED AS:

1. Domestic: <input type="checkbox"/> Household <input type="checkbox"/> Lawn & Garden <input checked="" type="checkbox"/> Livestock 2. <input type="checkbox"/> Irrigation 3. <input type="checkbox"/> Feedlot 4. <input type="checkbox"/> Industrial	5. <input type="checkbox"/> Public Water Supply: well ID	10. <input type="checkbox"/> Oil Field Water Supply: lease
6. <input type="checkbox"/> Dewatering: how many wells?	7. <input type="checkbox"/> Aquifer Recharge: well ID	11. Test Hole: well ID
8. <input type="checkbox"/> Monitoring: well ID	9. Environmental Remediation: well ID	12. Geothermal: how many bores?
<input type="checkbox"/> Air Sparge <input type="checkbox"/> Soil Vapor Extraction <input type="checkbox"/> Recovery <input type="checkbox"/> Injection	a) Closed Loop <input type="checkbox"/> Horizontal <input type="checkbox"/> Vertical b) Open Loop <input type="checkbox"/> Surface Discharge <input type="checkbox"/> Inj. of Water	13. <input type="checkbox"/> Other (specify):

Was a chemical/bacteriological sample submitted to KDHE? Yes No If yes, date sample was submitted:

Water well disinfected? Yes No

8 TYPE OF CASING USED: Steel PVC Other CASING JOINTS: Glued Clamped Welded Threaded
 Casing diameter**5**..... in. to**116**..... ft., Diameter in. to ft., Diameter in. to ft.
 Casing height above land surface**24**..... in. Weight**2.89**..... lbs./ft. Wall thickness or gauge No. **0.258**.....

TYPE OF SCREEN OR PERFORATION MATERIAL:
 Steel Stainless Steel Fiberglass PVC Other (Specify)

Brass Galvanized Steel Concrete tile None used (open hole)

SCREEN OR PERFORATION OPENINGS ARE:
 Continuous Slot Mill Slot Gauze Wrapped Torch Cut Drilled Holes Other (Specify)

Louvered Shutter Key Punched Wire Wrapped Saw Cut None (Open Hole)

SCREEN-PERFORATED INTERVALS: From**76**..... ft. to**116**..... ft., From ft. to ft., From ft. to ft.
GRAVEL PACK INTERVALS: From**20**..... ft. to**120**..... ft., From ft. to ft., From ft. to ft.

9 GROUT MATERIAL: Neat cement Cement grout Bentonite Other

Grout Intervals: From**0**..... ft. to**20**..... ft., From ft. to ft., From ft. to ft.

Nearest source of possible contamination:
 Septic Tank Lateral Lines Pit Privy Livestock Pens Insecticide Storage
 Sewer Lines Cess Pool Sewage Lagoon Fuel Storage Abandoned Water Well
 Watertight Sewer Lines Seepage Pit Feedyard Fertilizer Storage Oil Well/Gas Well
 Other (Specify)

Direction from well? Distance from well? ft.

10 FROM	TO	LITHOLOGIC LOG	FROM	TO	LITHO. LOG (cont.) or PLUGGING INTERVALS
0	2	surface	71	73	fine sand
2	15	loess	73	94	clay & caliche
15	29	clay	94	102	fine sand w/ caliche strks
29	37	fine to some med sand	102	110	limestone
37	42	clay & caliche	110	120	yellow ochre
42	51	fine to some med sand			
51	59	caliche & sandstone			
59	62	fine sand			
62	71	clay & caliche			

11 CONTRACTOR'S OR LANDOWNER'S CERTIFICATION: This water well was constructed, reconstructed, or plugged under my jurisdiction and was completed on (mo-day-year) **11-30-16**..... and this record is true to the best of my knowledge and belief. Kansas Water Well Contractor's License No. **838**..... This Water Well Record was completed on (mo-day-year) **12-4-16**..... under the business name of **RMD Drilling & Well Service, LLC**..... Signature *[Signature]*