


1 LOCATION OF WATER WELL: Fraction SE 1/4 SW 1/4 SE 1/4 Section Number 10 Township Number T 10 S Range Number R 26 W E/W  
 County: Sheridan

Distance and direction from nearest town or city street address of well if located within city?  
N/A - LOCATION CONFIRMED BY GMD #4

2 WATER WELL OWNER: Laura A. McWilliams Corder  
 RR#, St. Address, Box #: Rt 1 Box 62 Board of Agriculture, Division of Water Resources  
 City, State, ZIP Code: Selden, KS 67757 Application Number:

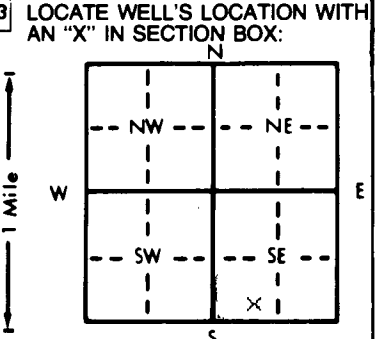

4 DEPTH OF COMPLETED WELL: 66' ft. ELEVATION:  
 Depth(s) Groundwater Encountered 1. 58' ft. 2. 66' ft. 3. 66' ft.  
 WELL'S STATIC WATER LEVEL 58' ft. below land surface measured on mo/day/yr Jan. 15, 1990  
 Pump test data: Well water was          ft. after          hours pumping          gpm  
 Est. Yield          gpm: Well water was          ft. after          hours pumping          gpm  
 Bore Hole Diameter          in. to          ft., and          in. to          ft.  
 WELL WATER TO BE USED AS: 5 Public water supply 8 Air conditioning 11 Injection well  
 X1 Domestic 3 Feedlot 6 Oil field water supply 9 Dewatering 12 Other (Specify below)  
 2 Irrigation 4 Industrial 7 Lawn and garden only 10 Monitoring well  
 Was a chemical/bacteriological sample submitted to Department? Yes.....No.....        ; If yes, mo/day/yr sample was submitted


5 TYPE OF BLANK CASING USED: 5 Wrought iron 8 Concrete tile CASING JOINTS: Glued.....Clamped.....  
 X1 Steel 3 RMP (SR) 6 Asbestos-Cement 9 Other (specify below) Welded.....  
 2 PVC 4 ABS 7 Fiberglass Threaded.....  
 Blank casing diameter 5 in. to          ft., Dia.          in. to          ft., Dia.          in. to          ft.  
 Casing height above land surface: 0 54 in., weight          lbs./ft. Wall thickness or gauge No.         

TYPE OF SCREEN OR PERFORATION MATERIAL: 7 PVC 10 Asbestos-cement  
 1 Steel 3 Stainless steel 5 Fiberglass 8 RMP (SR) 11 Other (specify).....  
 2 Brass 4 Galvanized steel 6 Concrete tile 9 ABS 12 None used (open hole)  
 SCREEN OR PERFORATION OPENINGS ARE: 5 Gauzed wrapped 8 Saw cut 11 None (open hole)  
 1 Continuous slot 3 Mill slot 6 Wire wrapped 9 Drilled holes  
 2 Louvered shutter 4 Key punched 7 Torch cut 10 Other (specify).....

SCREEN-PERFORATED INTERVALS: From          ft. to          ft., From          ft. to          ft.  
 GRAVEL PACK INTERVALS: From          ft. to          ft., From          ft. to          ft.  
 From          ft. to          ft., From          ft. to          ft.

6 GROUT MATERIAL: 1 Neat cement 2 Cement grout 3 Bentonite 4 Other.....  
 Grout intervals: From          ft. to          ft., From          ft. to          ft., From          ft. to          ft.  
 What is the nearest source of possible contamination:  
 1 Septic tank 4 Lateral lines 7 Pit privy 10 Livestock pens 14 Abandoned water well  
 2 Sewer lines 5 Cess pool 8 Sewage lagoon 11 Fuel storage 15 Oil well/Gas well  
 3 Watertight sewer lines 6 Seepage pit 9 Feedyard 12 Fertilizer storage 16 Other (specify below)  
 13 Insecticide storage  
 Direction from well?          How many feet?         

FROM	TO	LITHOLOGIC LOG	FROM	TO	PLUGGING INTERVALS
	ENTER				<i>Plugged to Company specifications</i>
		PLUGGING			
		INFORMATION			
		AT			
		RIGHT			

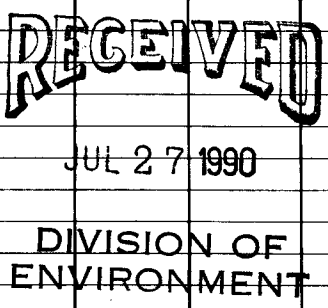

7 CONTRACTOR'S OR LANDOWNER'S CERTIFICATION: This water well was (1) constructed, (2) reconstructed, or (3) plugged under my jurisdiction and was completed on (mo/day/year)          and this record is true to the best of my knowledge and belief. Kansas  
 Water Well Contractor's License No.          This Water Well Record was completed on (mo/day/yr) March 14, 1990  
 under the business name of Self by (signature) Laura A. McWilliams Corder

OFFICE USE ONLY  
T  
R  
EW  
SEC.  
1/4  
1/4