WATER WELL RECORD Form WWC-5 KSA 82a-1212

1 LOCATION OF WATER WELL: County: Sheridan | Fraction: NE ¼ SW ¼ SW ¼ | Section Number: 30 | Township Number: T 10 S | Range Number: R 26 W E/W

Distance and direction from nearest town or city street address of well if located within city?
N/A - LOCATION CONFIRMED BY GMD #4

2 WATER WELL OWNER: Lloyd & Helen Tilton Rev. Trust
RR#, St. Address, Box # : 400 Grant
City, State, ZIP Code : Quinter, KS 67752
Board of Agriculture, Division of Water Resources
Application Number:

3 LOCATE WELL'S LOCATION WITH AN "X" IN SECTION BOX:

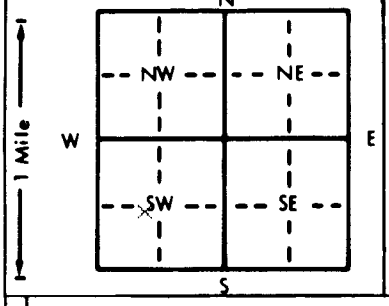

4 DEPTH OF COMPLETED WELL..... ft. ELEVATION:.....
Depth(s) Groundwater Encountered 1.....ft. 2.....ft. 3.....ft.
WELL'S STATIC WATER LEVEL..... ft. below land surface measured on mo/day/yr.....
Pump test data: Well water was..... ft. after..... hours pumping..... gpm
Est. Yield..... gpm: Well water was..... ft. after..... hours pumping..... gpm
Bore Hole Diameter.....in. to.....ft., and.....in. to.....ft.
WELL WATER TO BE USED AS: 5 Public water supply 8 Air conditioning 11 Injection well
1 Domestic 3 Feedlot 6 Oil field water supply 9 Dewatering 12 Other (Specify below)
X 2 Irrigation 4 Industrial 7 Lawn and garden only 10 Monitoring well.....
Was a chemical/bacteriological sample submitted to Department? Yes.....No.....; If yes, mo/day/yr sample was submitted Water Well Disinfected? Yes No

5 TYPE OF BLANK CASING USED: 5 Wrought iron 8 Concrete tile CASING JOINTS: Glued..... Clamped.....
X 1 Steel 3 RMP (SR) 6 Asbestos-Cement 9 Other (specify below) Welded.....
2 PVC 4 ABS 7 Fiberglass..... Threaded.....
Blank casing diameter 13 in. to.....ft., Dia.....in. to.....ft., Dia.....in. to.....ft.
Casing height above land surface 3 in., weight..... lbs./ft. Wall thickness or gauge No.....

TYPE OF SCREEN OR PERFORATION MATERIAL: 7 PVC 10 Asbestos-cement
1 Steel 3 Stainless steel 5 Fiberglass 8 RMP (SR) 11 Other (specify).....
2 Brass 4 Galvanized steel 6 Concrete tile 9 ABS 12 None used (open hole)

SCREEN OR PERFORATION OPENINGS ARE: 5 Gauzed wrapped 8 Saw cut 11 None (open hole)
1 Continuous slot 3 Mill slot 6 Wire wrapped 9 Drilled holes
2 Louvered shutter 4 Key punched 7 Torch cut 10 Other (specify).....

SCREEN-PERFORATED INTERVALS: From.....ft. to.....ft., From.....ft. to.....ft.
From.....ft. to.....ft., From.....ft. to.....ft.
GRAVEL PACK INTERVALS: From.....ft. to.....ft., From.....ft. to.....ft.
From ft. to ft., From ft. to ft.

6 GROUT MATERIAL: 1 Neat cement 2 Cement grout 3 Bentonite 4 Other.....
Grout Intervals: From.....ft. to.....ft., From.....ft. to.....ft., From.....ft. to.....ft.

What is the nearest source of possible contamination:
1 Septic tank 4 Lateral lines 7 Pit privy 10 Livestock pens 14 Abandoned water well
2 Sewer lines 5 Cess pool 8 Sewage lagoon 11 Fuel storage 15 Oil well/Gas well
3 Watertight sewer lines 6 Seepage pit 9 Feedyard 12 Fertilizer storage 16 Other (specify below)
13 Insecticide storage.....
Direction from well? How many feet?

FROM	TO	LITHOLOGIC LOG	FROM	TO	PLUGGING INTERVALS
	ENTER				Removed upper 3 ft of Casing
		PLUGGING			Sand + Clay 54-6
		INFORMATION			6-3 Cement
		AT			3 ft Clay fill
		RIGHT			

RECEIVED
SEP 27 1990
DIVISION OF ENVIRONMENT

7 CONTRACTOR'S OR LANDOWNER'S CERTIFICATION: This water well was (1) constructed, (2) reconstructed, or (3) plugged under my jurisdiction and was completed on (mo/day/year) 8-21-90 and this record is true to the best of my knowledge and belief. Kansas Water Well Contractor's License No..... This Water Well Record was completed on (mo/day/yr).....
under the business name of by (signature)

OFFICE USE ONLY T R E/W SEC. ¼ ¼ ¼