USE TYPEWRITER OR BALL POINT PEN-PRESS FIRMLY, PRINT CLEARLY.

WATER WELL RECORD
KSA 82a-1201-1215

Kansas Department of Health and Environment-Division of Environment
(Water well Contractors)
Topeka, Kansas 66620

1. Location of well:	County	Fraction	Section number	Township number	Range number
	Sheridan	NE 1/4 SW 1/4 SW 1/4	19	T 10 S	R 27 E/W DRL

X Distance and direction from nearest town or city: N - 1W of Park

Street address of well location if in city:

3. Owner of well: Jerry Goetz
R.R. or street: Park, Ks. 67751
City, state, zip code:

4. Locate with "X" in section below:

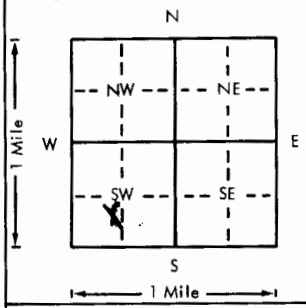

Sketch map:

6. Bore hole dia. 22 28 in. Completion date
Well depth 56 ft. 3/18/77

7. __ Cable tool __ Rotary __ Driven __ Dug
__ Hollow rod __ Jetted __ Bored X Reverse rotary

8. Use: __ Domestic __ Public supply __ Industry
X Irrigation __ Air conditioning __ Stock
__ Lawn __ Oil field water __ Other

9. Casing: Material ptls Height: above or below
Threaded ___ Welded gl Surface 12 in.
RMP ___ PVC X Weight ___ lbs./ft.
Dia. 16 in. to 56 ft. depth Wall Thickness: inches or
Dia. ___ in. to ___ ft. depth gage No.

5. Type and color of material	From	To
silt + clay	0	30
sand + gravel	30	55
yellow clay	55	56

(Use a second sheet if needed)

10. Screen: Manufacturer's name Peerless Plastic
Type PVC Dia. 16 in.
Slot/gauze 1/4 Length 20 ft.
Set between 36 ft. and 56 ft.
___ ft. and ___ ft.
Gravel pack? X Size range of material 1/4 down

11. Static water level:
20 ft. below land surface Date 3/18/77 mo./day/yr.

12. Pumping level below land surfaces:
___ ft. after ___ hrs. pumping ___ g.p.m.
___ ft. after ___ hrs. pumping ___ g.p.m.
Estimated maximum yield 400 g.p.m.

13. Water sample submitted: mo./day/yr.
___ Yes X No Date

14. Well head completion:
___ Pitless adapter ___ Inches above grade

15. Well grouted? yes Cement slab
With: ___ Neat cement ___ Bentonite ✓ Concrete
Depth: From 0 ft. to 5 ft.

16. Nearest source of possible contamination:
ft. ___ Direction ___ Type
Well disinfected upon completion? ___ Yes ___ No

17. Pump: X Not installed
Manufacturer's name
Model number ___ HP ___ Volts
Length of drop pipe ___ ft. capacity ___ g.p.m.
Type:
___ Submersible ___ Turbine
___ Jet ___ Reciprocating
___ Centrifugal ___ Other

T R E/W Sec 1/4 1/4 1/4

18. Elevation:

Topography:
___ Hill
___ Slope
___ Upland
✓ Valley

19. Remarks:

20. Water well contractor's certification:
This well was drilled under my jurisdiction and this report is true to the best of my knowledge and belief.
Aqua Well Drilling 281
Business name License No.
Address Gove, Ks. 67736
Signed J. M. Tuttle Date 6-20-77
Authorized representative

Forward the white, blue and pink copies to the Department of Health and Environment

Form WWC-5

MI-1023