


1 LOCATION OF WATER WELL: County: Sheldon Fraction: SE 1/4 SW 1/4 SW 1/4 Section Number: 7 Township Number: T 100 Range Number: R 27 E/W

Distance and direction from nearest town or city street address of well if located within city? 5m 1w of Park

2 WATER WELL OWNER: Ralph Jerr RR#, St. Address, Box #: Park, KS 67751 Board of Agriculture, Division of Water Resources Application Number:

3 LOCATE WELL'S LOCATION WITH AN "X" IN SECTION BOX:

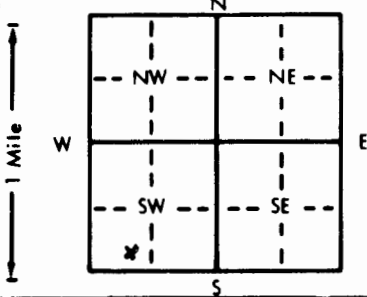

4 DEPTH OF COMPLETED WELL: 112 ft. ELEVATION: 80 ft.

Depth(s) Groundwater Encountered 1. 80 ft. 2. ft. 3. ft.  
WELL'S STATIC WATER LEVEL: 80 ft. below land surface measured on mo/day/yr

Pump test data: Well water was ft. after hours pumping gpm  
Est. Yield 25 gpm Well water was ft. after hours pumping gpm

Bore Hole Diameter: 9 in. to 112 ft., and in. to ft.  
WELL WATER TO BE USED AS: 5 Public water supply 8 Air conditioning 11 Injection well  
 Domestic 3 Feedlot 6 Oil field water supply 9 Dewatering 12 Other (Specify below)

2 Irrigation 4 Industrial 7 Lawn and garden only 10 Monitoring well  
Was a chemical/bacteriological sample submitted to Department? Yes No ; If yes, mo/day/yr sample was submitted  
Water Well Disinfected? Yes  No

5 TYPE OF BLANK CASING USED: 1 Steel 3 RMP (SR) 5 Wrought iron 8 Concrete tile CASING JOINTS: Glued  Clamped  
 PVC 4 ABS 7 Fiberglass 9 Other (specify below) Welded

Blank casing diameter 0 in. to 102 ft., Dia. in. to ft., Dia. in. to ft.  
Casing height above land surface 12 in., weight 250 lbs./ft. Wall thickness or gauge No. 250

TYPE OF SCREEN OR PERFORATION MATERIAL:  PVC 10 Asbestos-cement  
1 Steel 3 Stainless steel 5 Fiberglass 8 RMP (SR) 11 Other (specify)

2 Brass 4 Galvanized steel 6 Concrete tile 9 ABS 12 None used (open hole)

SCREEN OR PERFORATION OPENINGS ARE:  Continuous slot 3 Mill slot 5 Gauzed wrapped 8 Saw cut 11 None (open hole)  
2 Louvered shutter 4 Key punched 6 Wire wrapped 9 Drilled holes

7 Torch cut 10 Other (specify)

SCREEN-PERFORATED INTERVALS: From 102 ft. to 112 ft., From ft. to ft.  
From ft. to ft., From ft. to ft.

GRAVEL PACK INTERVALS: From 80 ft. to 112 ft., From ft. to ft.  
From ft. to ft., From ft. to ft.

6 GROUT MATERIAL:  Neat cement 2 Cement grout 3 Bentonite 4 Other  
Grout Intervals: From 0 ft. to 20 ft., From ft. to ft., From ft. to ft.

What is the nearest source of possible contamination:  Livestock pens 14 Abandoned water well  
1 Septic tank 4 Lateral lines 7 Pit privy 11 Fuel storage 15 Oil well/Gas well  
2 Sewer lines 5 Cess pool 8 Sewage lagoon 12 Fertilizer storage 16 Other (specify below)  
3 Watertight sewer lines 6 Seepage pit 9 Feedyard 13 Insecticide storage

Direction from well? East How many feet? 200

FROM	TO	LITHOLOGIC LOG	FROM	TO	PLUGGING INTERVALS
0	19	Topsoil			
19	45	Sandy Clay			
45	61	3" Shovel			
61	90	Sandy Clay			
90	111	3" Shovel			
111	112	Shale			

7 CONTRACTOR'S OR LANDOWNER'S CERTIFICATION: This water well was  constructed, (2) reconstructed, or (3) plugged under my jurisdiction and was completed on (mo/day/year) 12-3-92 and this record is true to the best of my knowledge and belief. Kansas Water Well Contractor's License No. 376 This Water Well Record was completed on (mo/day/yr) 1-2-95 under the business name of B & B Dulling by (signature) Joseph B. Dulling