

HUXIE 3NE

USE TYPEWRITER OR BALL POINT PEN-PRESS FIRMLY, PRINT CLEARLY.

T R EW sec 1/4 1/4 1/4 No.


WATER WELL RECORD
KSA 82a-1201-1215

Kansas State Dept. Of Health
(Water Well Contractors)
Forbes-Bldg. 740
Topeka, Kansas 66620

CCC

1 Location of well:	County COVE	Township name	Fraction SW-SW-SW	Section number 34	Town number 10	Range number 27 W
---------------------	-----------------------	---------------	-----------------------------	-----------------------------	--------------------------	-----------------------------

Distance and direction from nearest town or city: BRK. Ks.	3 Owner of well: NORBERT FELDT
Street address of well location if in city:	Address: Dodge City, Ks.

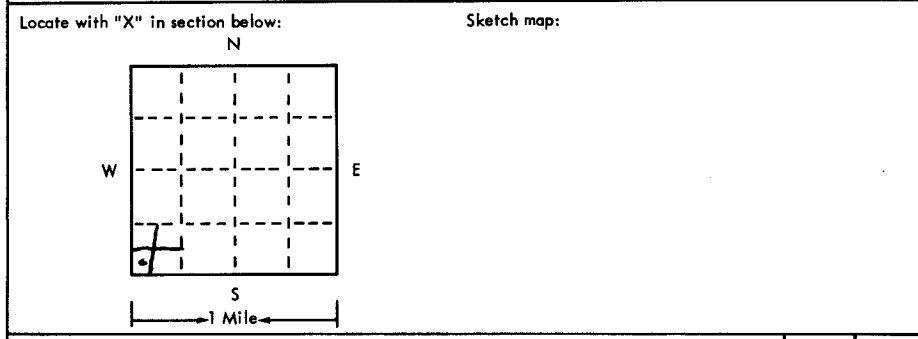

2	Type and color of material	From	To
	<i>Top soil</i>	<i>0</i>	<i>9</i>
	<i>sandy clay</i>	<i>9</i>	<i>14</i>
	<i>m. gravel. f. sand</i>	<i>14</i>	<i>37</i>
	<i>sandy clay</i>	<i>37</i>	<i>47</i>
	<i>Other</i>	<i>47</i>	<i>53</i>
	<i>BRUCK 47'</i>		

4 Well depth: **53** ft. Date of completion: **7/8/77**
Well diameter **9** in.

5 Cable tool Rotary Driven Dug
 Hollow rod Jetted Bored Reverse rotary

6 Use: Domestic Public supply Industry
 Irrigation Air conditioning Commercial
 Test well

7 Casing: Material **PVC** Height: above/below
Threaded Welded Surface **12** in.
Diam. **5** in. to **53** ft. depth Drive shoe? Yes No
5 in. to **53** ft. depth

8 Screen:
Manufacturer **Dees Howell**
Type **PVC** Dia. **5**
Slot/gauze **12** Length **8'**
Set between **46** ft. and **53**
Fittings:
Gravel pack Yes No Size range of material **1/2-1/4**

9 Static water level:
24 ft. below land surface Date **3/8/77**

10 Pumping level below land surfaces:
____ ft. after ____ hrs. pumping ____ g.p.m.
____ ft. after ____ hrs. pumping ____ g.p.m.
Estimated maximum yield **30** g.p.m. *Plus*

11 Water sample submitted:
 Yes No Date ____

12 Well head completion:
 Pitless adapter **1A** Inches above grade

13 Well grouted? Yes No
 Neat cement Bentonite
Depth: From **0** ft. to **10** ft.

14 Nearest source of possible contamination: **N/A.**
ft. ____ Direction ____ Type ____
Well disinfected upon completion? Yes No

15 Pump: Not installed
Manufacturer's name ____
Model number ____ HP ____ Volts ____
Length of drop pipe ____ ft. capacity ____ g.m.p.
Type:
 Submersible Turbine
 Jet Reciprocating
 Centrifugal Other *mill*

16 Remarks: elevation **2665 (TOPO)**

Topography:
 Hill
 Slope
 Upland
 Valley

17 Water well contractor's certification:
This well was drilled under my jurisdiction and this report is true to the best of my knowledge and belief.
STRUCKHOFF SONS 298
Business name License No.
Address **BRINNEAU, Ks**
Signed **Struckhoff** Date **4/22/77**
Authorized representative

10 27W 34 SW SW SW