


1 LOCATION OF WATER WELL: County: **SHERIDAN** Fraction: **NW 1/4 SW 1/4 NW 1/4** Section Number: **27** Township Number: **T 10 S** Range Number: **R 28 E/W**

Distance and direction from nearest town or city street address of well if located within city?

1 EAST, 4 NORTH GRAINFIELD KS.

2 WATER WELL OWNER: **CAROL KLEWER**
 RR#, St. Address, Box #: **PO BOX 146** Board of Agriculture, Division of Water Resources
 City, State, ZIP Code: **GRAINFIELD, KS 67737** Application Number:

3 LOCATE WELL'S LOCATION WITH AN "X" IN SECTION BOX:

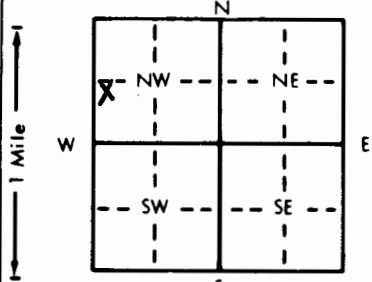

4 DEPTH OF COMPLETED WELL: **64** ft. ELEVATION: ft.
 Depth(s) Groundwater Encountered 1. **20** ft. 2. ft. 3. ft.
 WELL'S STATIC WATER LEVEL: **20** ft. below land surface measured on mo/day/yr
 Pump test data: Well water was ft. after hours pumping gpm
 Est. Yield: **15** gpm. Well water was ft. after hours pumping gpm
 Bore Hole Diameter: **8 3/4** in. to **6 1/4** in. and in. to ft.
 WELL WATER TO BE USED AS:
 5 Public water supply 8 Air conditioning 11 Injection well
 1 Domestic 3 Feedlot 6 Oil field water supply 9 Dewatering Other (Specify below)
 2 Irrigation 4 Industrial 7 Lawn and garden only 10 Monitoring well **Pasture**
 Was a chemical/bacteriological sample submitted to Department? Yes No If yes, mo/day/yr sample was submitted
 Water Well Disinfected? Yes No

5 TYPE OF BLANK CASING USED:
 1 Steel 3 RMP (SR) 5 Wrought iron 8 Concrete tile CASING JOINTS: Glued Clamped
 PVC 4 ABS 6 Asbestos-Cement 9 Other (specify below) Welded
 7 Fiberglass Threaded

Blank casing diameter: **5** in. to **5 1/4** in. Dia. in. to ft. Dia. in. to ft.
 Casing height above land surface: **24** in. weight **16.0** lbs./ft. Wall thickness or gauge No.

TYPE OF SCREEN OR PERFORATION MATERIAL:
 1 Steel 3 Stainless steel 5 Fiberglass PVC 10 Asbestos-cement
 2 Brass 4 Galvanized steel 6 Concrete tile 8 RMP (SR) 11 Other (specify)
 9 ABS 12 None used (open hole)

SCREEN OR PERFORATION OPENINGS ARE:
 1 Continuous slot Mill slot 5 Gauzed wrapped 8 Saw cut 11 None (open hole)
 2 Louvered shutter 4 Key punched 6 Wire wrapped 9 Drilled holes
 7 Torch cut 10 Other (specify)

SCREEN-PERFORATED INTERVALS: From **54** ft. to **64** ft. From ft. to ft.
 From ft. to ft. From ft. to ft.
 GRAVEL PACK INTERVALS: From **52** ft. to **64** ft. From ft. to ft.
 From ft. to ft. From ft. to ft.

6 GROUT MATERIAL: 1 Neat cement 2 Cement grout Bentonite 4 Other
 Grout Intervals: From **0** ft. to **25** ft. From ft. to ft. From ft. to ft.

What is the nearest source of possible contamination:
 1 Septic tank 4 Lateral lines 7 Pit privy 10 Livestock pens Abandoned water well
 2 Sewer lines 5 Cess pool 8 Sewage lagoon 11 Fuel storage 15 Oil well/Gas well
 3 Watertight sewer lines 6 Seepage pit 9 Feedyard 12 Fertilizer storage 16 Other (specify below)
 13 Insecticide storage

Direction from well? **EAST** How many feet? **400**

FROM	TO	LITHOLOGIC LOG	FROM	TO	PLUGGING INTERVALS
0	5	TOPSOIL			
5	37	BROWN CLAY			
37	47	SAND W/ CLAY			
47	55	SAND			
55	56	YELLOW CLAY			
56	61	SAND			
61	64	HARD GRAY CLAY			

7 CONTRACTOR'S OR LANDOWNER'S CERTIFICATION: This water well was constructed, reconstructed, or plugged under my jurisdiction and was completed on (mo/day/year) **9-26-05** and this record is true to the best of my knowledge and belief. Kansas Water Well Contractor's License No. **489** This Water Well Record was completed on (mo/day/yr) **9-29-05** under the business name of **AQUA PUMP** by (signature) **Van M. Jacobs**

OFFICE USE ONLY T R E/W SEC 1/4 1/4 1/4