


HOXIE 3NW

WATER WELL RECORD  
KSA 82a-1201-1215

Kansas Department of Health and  
Environment-Division of Environment  
(Water well Contractors)  
Topeka, Kansas 66620

BBA

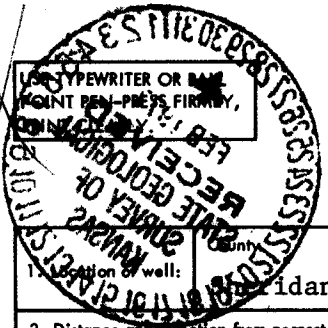

1. Location of well: <u>Idian</u>	Fraction: <u>NE 1/4 NW 1/4 NW 1/4</u>	Section number: <u>#5</u>	Township number: <u>T 10 S R 28</u>	Range number: <u>X/W</u>
-----------------------------------	---------------------------------------	---------------------------	-------------------------------------	--------------------------

2. Distance and direction from nearest town or city: <u>From Hoxie, Ks., 9 miles South, 1 3/4 miles West.</u>	3. Owner of well: <u>Mark Schippers</u>
Street address of well location if in city:	R.R. or street:
	City, state, zip code: <u>Grainfield, Kansas</u>

4. Locate with "X" in section below: Sketch map:

N

S

6. Bore hole dia. 30 in. Completion date 11-13-75  
Well depth 189 ft.

7.  Cable tool  Rotary  Driven  Dug  
 Hollow rod  Jetted  Bored  Reverse rotary

8. Use:  Domestic  Public supply  Industry  
 Irrigation  Air conditioning  Stock  
 Lawn  Oil field water  Other

9. Casing: Material steel Height Above or below  
Threaded  Welded  Surface 12 in.  
RMP  PVC  Weight 188 lbs./ft.  
Dia. 16 in. to 119 ft. depth Wall Thickness: inches  
Dia. in. to ft. depth gage No. #7 gauge

5. Type and color of material	From	To
Clay	0	45
Coarse sand & gravel	45	66
Sandy clay	66	75
Coarse sand & gravel	75	84
Sandy clay & cemented streaks	84	98
Coarse sand & gravel- clay streaks	98	115
Coarse sand & gravel	115	144
Cement	144	145
Sandy clay & sand streaks	145	160
Clay	160	167
Sandy clay	167	170
Coarse sand & gravel	170	177
Clay	177	184
Coarse sand & gravel	184	186
Clay	186	189
Coarse sand & gravel	189	---
Shale	---	---

10. Screen: Manufacturer's name W. A. Brown  
Type regular Dia. 16"  
Slot gauge 10% Length 60'  
Set between 119' ft. and 179' ft.  
10' of cook ft. and 189' ft.  
Gravel pack? yes Size range of material X X 5/8

11. Static water level: 113' mo./day/yr.  
113' ft. below land surface Date 11-15-75

12. Pumping level below land surfaces:  
182' ft. after 3 hrs. pumping 627 g.p.m.  
ft. after hrs. pumping g.p.m.  
Estimated maximum yield 650 g.p.m.

13. Water sample submitted: mo./day/yr.  
Yes  No  Date

14. Well head completion:  
 Pitless adapter 12 inches above grade

15. Well grouted? yes & clay  
With:  Neat cement  Bentonite  Concrete  
Depth: From 0 ft. to 10 ft.

16. Nearest source of possible contamination:  
ft. 5000' Direction N-NW Type Farm  
Well disinfected upon completion?  Yes  No

17. Pump:  Not installed  
Manufacturer's name Floway  
Model number 10 DOH HP 60 780  
Length of drop pipe 186 ft. capacity g.p.m.  
Type:  
 Submersible  Turbine  
 Jet  Reciprocating  
 Centrifugal  Other

18. Elevation:

19. Remarks: BROOK 189'  
2801 (TUPO)

Topography:  
 Hill  
 Slope  
 Upland  
 Valley

20. Water well contractor's certification:  
This well was drilled under my jurisdiction and this report is true to the best of my knowledge and belief.  
Western Well & Pump, Inc. 245  
Business name P.O. Box 852, Colby, Ks. License No.  
Address Ray F. Senior Date Jan 2  
Signed Ray F. Senior Authorized representative

10 28 5  
T  
R  
S  
NE  
1/4  
1/4  
1/4

Forward the white, blue and pink copies to the Department of Health and Environment

Form WWC-5