USE TYPEWRITER OR BALL POINT PEN-PRESS FIRMLY, PRINT CLEARLY.

WATER WELL RECORD
KSA 82a-1201-1215

Kansas Department of Health and Environment-Division of Environment
(Water well Contractors)
Topeka, Kansas 66620

1. Location of well:	County	Fraction	Section number	Township number	Range number
	Sheridan	SW 1/4 NE 1/4 SE 1/4	28	T ~~28~~ 10 S	R 28 E/W

2. Distance and direction from nearest town or city:
Street address of well location if in city: 1E 2½ N of wolf Grainfield

3. Owner of well: Don Zigler
R.R. or street:
City, state, zip code: Grainfield Ks

4. Locate with "X" in section below: Sketch map

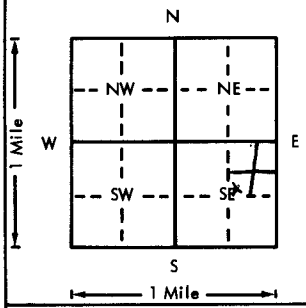

6. Bore hole dia. 9 in. Completion date Finished himself
Well depth 83 ft. 5-11-80

7. __ Cable tool X Rotary __ Driven __ Dug
__ Hollow rod __ Jetted __ Bored __ Reverse rotary

8. Use: __ Domestic __ Public supply __ Industry
__ Irrigation __ Air conditioning X Stock
__ Lawn __ Oil field water __ Other

9. Casing: Material _____ Height: Above or below
Threaded ____ Welded ____ Surface 12 in.
RMP ____ PVC X Weight 200 psi lbs./ft.
Dia. 8 in. to 83 ft. depth Wall Thickness: inches or
Dia. ____ in. to ____ ft. depth gage No. 1/4 200.

5. Type and color of material	From	To
Top soil	0	5
Sandy clay	5	10
M gravel	10	16
Sandy Clay	16	38
Gravel	38	41
S. clay	41	70
Fine sand M. gravel	70	76
S clay	76	81
Ochre	81	83
(Use a second sheet if needed)		

10. Screen: Manufacturer's name Jess Lowell
Type PVC Dia. 5"
Slot/gauze 1/16-1/8 Length 8'
Set between 75 ft. and 83 ft.
____ ft. and ____ ft.
Gravel pack? X Size range of material 1/4-3/8

11. Static water level: mo./day/yr.
41 ft. below land surface Date 5-11-80

12. Pumping level below land surfaces:
____ ft. after ____ hrs. pumping ____ g.p.m.
____ ft. after ____ hrs. pumping ____ g.p.m.
Estimated maximum yield 30 g.p.m.

13. Water sample submitted: mo./day/yr.
__ Yes X No Date

14. Well head completion:
__ Pitless adapter 12 Inches above grade

15. Well grouted? X
With: __ Neat cement X Bentonite __ Concrete
Depth: From 6 ft. to 10 ft.

16. Nearest source of possible contamination:
ft. 1000 Direction N Type Cattle
Well disinfected upon completion? X Yes __ No

17. Pump: __ Not installed
Manufacturer's name Windmill
Model number ____ HP ____ Volts ____
Length of drop pipe ____ ft. capacity ____ g.p.m.
Type:
__ Submersible __ Turbine
__ Jet __ Reciprocating
__ Centrifugal __ Other

18. Elevation:

Topography:
X Hill
__ Slope
__ Upland
__ Valley

19. Remarks:

20. Water well contractor's certification:
This well was drilled under my jurisdiction and this report is true to the best of my knowledge and belief.
B & B Drilling 376
Business name License No.
Address Quinter Ks
Signed Joseph Beckman Date 9-15-80
Authorized representative

T 10 R 28 E/W Sec 28 1/4 SW 1/4 NE 1/4 SE 1/4

Forward the white, blue and pink copies to the Department of Health and Environment

Form WWC-5

MI-1023