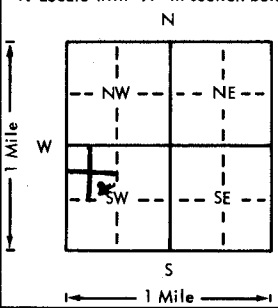


USE TYPEWRITER OR BALL POINT PEN-PRESS FIRMLY, PRINT CLEARLY.

WATER WELL RECORD
KSA 82a-1201-1215

CRD

Kansas Department of Health and Environment-Division of Environment
(Water well Contractors)
Topeka, Kansas 66620

1. Location of well: County SHERIDAN Fraction SE 1/4 NW 1/4 SW 1/4 Section number 33 Township number T 10 S Range number R 28 E 10																															
2. Distance and direction from nearest town or city: Street address of well location if in city: 1 E 1/2 E 1/4 of Mainfield 3. Owner of well: Carl Kaiser R. or street: Mainfield, Kansas City, state, zip code: Mainfield, Kansas																															
4. Locate with "X" in section below: Sketch map: 																															
5. Type and color of material																															
<table border="1" style="width:100%; border-collapse: collapse;"> <thead> <tr> <th style="width:80%;"></th> <th style="width:10%;">From</th> <th style="width:10%;">To</th> </tr> </thead> <tbody> <tr> <td>Top soil</td> <td>0</td> <td>23</td> </tr> <tr> <td>Sandy Clay</td> <td>23</td> <td>100</td> </tr> <tr> <td>M. gravel, gravel</td> <td>100</td> <td>114</td> </tr> <tr> <td>Sandy Clay</td> <td>114</td> <td>125</td> </tr> <tr> <td>M. gravel, gravel</td> <td>125</td> <td>136</td> </tr> <tr> <td>Sandy Clay</td> <td>136</td> <td>150</td> </tr> <tr> <td>M. gravel, gravel</td> <td>150</td> <td>155</td> </tr> <tr> <td>Other</td> <td>155</td> <td>157</td> </tr> <tr> <td colspan="3" style="text-align:center;">BROCK ISS</td> </tr> </tbody> </table>			From	To	Top soil	0	23	Sandy Clay	23	100	M. gravel, gravel	100	114	Sandy Clay	114	125	M. gravel, gravel	125	136	Sandy Clay	136	150	M. gravel, gravel	150	155	Other	155	157	BROCK ISS		
	From	To																													
Top soil	0	23																													
Sandy Clay	23	100																													
M. gravel, gravel	100	114																													
Sandy Clay	114	125																													
M. gravel, gravel	125	136																													
Sandy Clay	136	150																													
M. gravel, gravel	150	155																													
Other	155	157																													
BROCK ISS																															
6. Bore hole dia. 9 in. Completion date 9-3-79 Well depth 157 ft.																															
7. <input type="checkbox"/> Cable tool <input checked="" type="checkbox"/> Rotary <input type="checkbox"/> Driven <input type="checkbox"/> Dug <input type="checkbox"/> Hollow rod <input type="checkbox"/> Jetted <input type="checkbox"/> Bored <input type="checkbox"/> Reverse rotary																															
8. Use: <input checked="" type="checkbox"/> Domestic <input type="checkbox"/> Public supply <input type="checkbox"/> Industry <input type="checkbox"/> Irrigation <input type="checkbox"/> Air conditioning <input type="checkbox"/> Stock <input type="checkbox"/> Lawn <input type="checkbox"/> Oil field water <input type="checkbox"/> Other																															
9. Casing: Material <input type="checkbox"/> Threaded <input type="checkbox"/> Welded <input type="checkbox"/> Surface 12 in. RMP <input type="checkbox"/> PVC <input checked="" type="checkbox"/> Weight 200/51 lbs./ft. Dia. 5 in. to 57 ft. depth Wall Thickness: inches or Dia. <input type="checkbox"/> in. to <input type="checkbox"/> ft. depth gage No. 30																															
10. Screen: Manufacturer's name Jesse Overell Type DUC Dia. 5" Slot/gauze 32 Length 8' Set between 149 ft. and 157 ft. ft. and <input type="checkbox"/> ft. Gravel pack? <input checked="" type="checkbox"/> Size range of material 20-40																															
11. Static water level: <input checked="" type="checkbox"/> 105 ft. below land surface Date 9-5-79 mo./day/yr.																															
12. Pumping level below land surfaces: <input type="checkbox"/> ft. after <input type="checkbox"/> hrs. pumping <input type="checkbox"/> g.p.m. <input type="checkbox"/> ft. after <input type="checkbox"/> hrs. pumping <input type="checkbox"/> g.p.m. Estimated maximum yield 30 g.p.m.																															
13. Water sample submitted: <input type="checkbox"/> Yes <input checked="" type="checkbox"/> No Date <input type="checkbox"/>																															
14. Well head completion: <input checked="" type="checkbox"/> Pitless adapter 12 inches above grade																															
15. Well grouted? <input checked="" type="checkbox"/> With: <input checked="" type="checkbox"/> Neat cement <input type="checkbox"/> Bentonite <input type="checkbox"/> Concrete Depth: From 2 ft. to 10 ft. 4'6" 141																															
16. Nearest source of possible contamination: ft. 200 Direction N Type Cellar Well disinfected upon completion? <input checked="" type="checkbox"/> Yes <input type="checkbox"/> No																															
17. Pump: Not installed Manufacturer's name Red Jacket Model number <input type="checkbox"/> HP 3/4 Volts 230 Length of drop pipe 130 ft. capacity 10 g.p.m. Type: <input checked="" type="checkbox"/> Submersible <input type="checkbox"/> Turbine <input type="checkbox"/> Jet <input type="checkbox"/> Reciprocating <input type="checkbox"/> Centrifugal <input type="checkbox"/> Other																															
(Use a second sheet if needed)																															
18. Elevation: Topography: <input type="checkbox"/> Hill <input type="checkbox"/> Slope <input checked="" type="checkbox"/> Upland <input type="checkbox"/> Valley	19. Remarks:																														
20. Water well contractor's certification: This well was drilled under my jurisdiction and this report is true to the best of my knowledge and belief. B+B Drilling 376 Business name License No. Address Drinnell Ks Signed Joseph Budman Date 9-5-79 Authorized representative																															

10 28 W 33 SE NW SW
T R Sec