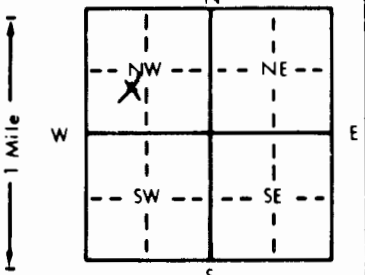


1 LOCATION OF WATER WELL: Fraction NE 1/4 SW 1/4 NW 1/4 Section Number 6 Township Number T 10 S Range Number R 29 E  
 County: SHERIDAN

Distance and direction from nearest town or city street address of well if located within city?  
1/2 mile NE of Grainne, KS

2 WATER WELL OWNER: Murray Baalman  
 RR#, St. Address, Box #: Samuel, Gary Board of Agriculture, Division of Water Resources  
 City, State, ZIP Code: GRAINNE, KS 67738 Application Number:

3 LOCATE WELL'S LOCATION WITH AN "X" IN SECTION BOX:  4 DEPTH OF COMPLETED WELL: 166 ft. ELEVATION:  
 Depth(s) Groundwater Encountered 1. 110 ft. 2. . ft. 3. . ft.  
 WELL'S STATIC WATER LEVEL: 110 ft. below land surface measured on mo/day/yr  
 Pump test data: Well water was . ft. after . hours pumping . gpm  
 Est. Yield: 35 gpm Well water was . ft. after . hours pumping . gpm  
 Bore Hole Diameter: 9 in. to 16.6 ft., and . in. to . ft.  
 WELL WATER TO BE USED AS:  
 1 Domestic 3 Feedlot  6 Oil field water supply 8 Air conditioning 11 Injection well  
 2 Irrigation 4 Industrial 7 Lawn and garden only 9 Dewatering 12 Other (Specify below)  
 Was a chemical/bacteriological sample submitted to Department? Yes . No  If yes, mo/day/yr sample was submitted  
 Water Well Disinfected? Yes  No

5 TYPE OF BLANK CASING USED:  
 1 Steel 3 RMP (SR) 5 Wrought iron 8 Concrete tile CASING JOINTS: Glued  Clamped .  
 2 PVC 4 ABS 6 Asbestos-Cement 9 Other (specify below) Welded .  
 7 Fiberglass Threaded .  
 Blank casing diameter . in. to 12.6 ft., Dia . in. to . ft., Dia . in. to . ft.  
 Casing height above land surface: 12 in., weight 2.50 lbs./ft. Wall thickness or gauge No. 250  
 TYPE OF SCREEN OR PERFORATION MATERIAL:  
 1 Steel 3 Stainless steel 5 Fiberglass 8 RMP (SR) 10 Asbestos-cement  
 2 Brass 4 Galvanized steel 6 Concrete tile 9 ABS 11 Other (specify) .  
 12 None used (open hole)  
 SCREEN OR PERFORATION OPENINGS ARE:  
 1 Continuous slot 3 Mill slot 5 Gauzed wrapped 8 Saw cut 11 None (open hole)  
 2 Louvered shutter 4 Key punched 6 Wire wrapped 9 Drilled holes  
 7 Torch cut 10 Other (specify) .  
 SCREEN-PERFORATED INTERVALS: From 12.6 ft. to 16.6 ft., From . ft. to . ft.  
 From . ft. to . ft., From . ft. to . ft.  
 GRAVEL PACK INTERVALS: From 110 ft. to 16.6 ft., From . ft. to . ft.  
 From . ft. to . ft., From . ft. to . ft.

6 GROUT MATERIAL: 1 Neat cement 2 Cement grout  3 Bentonite 4 Other .  
 Grout Intervals: From 0 ft. to 90 ft., From . ft. to . ft., From . ft. to . ft.  
 What is the nearest source of possible contamination:  
 1 Septic tank 4 Lateral lines 7 Pit privy 10 Livestock pens 14 Abandoned water well  
 2 Sewer lines 5 Cess pool 8 Sewage lagoon 11 Fuel storage 15 Oil well/Gas well  
 3 Watertight sewer lines 6 Seepage pit 9 Feedyard 12 Fertilizer storage 16 Other (specify below)  
Flatland  
 Direction from well? 0 How many feet? 0

FROM	TO	LITHOLOGIC LOG	FROM	TO	PLUGGING INTERVALS
0	14	Top soil			
14	50	Clay			
50	75	Sand			
75	80	Sandy Clay			
80	117	m. shale			
117	165	S clay sand streaks			
165	166	Shale			

7 CONTRACTOR'S OR LANDOWNER'S CERTIFICATION: This water well was  constructed, (2) reconstructed, or (3) plugged under my jurisdiction and was completed on (mo/day/year) 11-25-14 and this record is true to the best of my knowledge and belief. Kansas Water Well Contractor's License No. 374 This Water Well Record was completed on (mo/day/yr) 12-30-14 under the business name of B+B Duthaj LLC by (signature) Joseph Beckner

OFFICE USE ONLY  
T  
R  
EW  
SEC.  
1/4  
1/4  
1/4