


1 LOCATION OF WATER WELL: Fraction 1/4 SW 1/4 NW 1/4 Section Number 15 Township Number T 10 S Range Number R 29 E
 County: Sheridan

Distance and direction from nearest town or city street address of well if located within city?
7 E - 3/4 S Angelus Ks.

2 WATER WELL OWNER: Joe Bixman Board of Agriculture, Division of Water Resources
 RR#, St. Address, Box #: RR City, State, ZIP Code: Grainfield Ks Application Number: 15-550

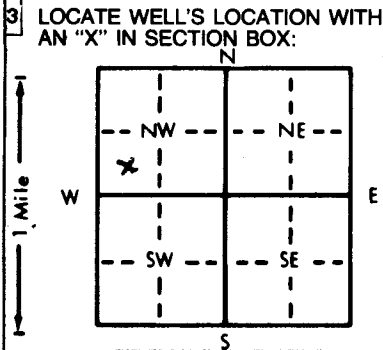

4 DEPTH OF COMPLETED WELL: 175 ft. ELEVATION: _____
 Depth(s) Groundwater Encountered 1. 100 ft. 2. _____ ft. 3. _____ ft.
 WELL'S STATIC WATER LEVEL: 100 ft. below land surface measured on mo/day/yr
 Pump test data: Well water was _____ ft. after _____ hours pumping _____ gpm
 Est. Yield 450 gpm: Well water was _____ ft. after _____ hours pumping _____ gpm
 Bore Hole Diameter: 2.5 in. to 1.75 in. and _____ in. to _____ in.
 WELL WATER TO BE USED AS:
 5 Public water supply 8 Air conditioning 11 Injection well
 1 Domestic 3 Feedlot 6 Oil field water supply 9 Dewatering 12 Other (Specify below)
 2 Irrigation 4 Industrial 7 Lawn and garden only 10 Observation well
 Was a chemical/bacteriological sample submitted to Department? Yes _____ No ; If yes, mo/day/yr sample was submitted _____
 Water Well Disinfected? Yes _____ No

5 TYPE OF BLANK CASING USED:
 1 Steel 3 RMP (SR) 5 Wrought iron 8 Concrete tile CASING JOINTS: Glued _____ Clamped _____
 2 PVC 4 ABS 6 Asbestos-Cement 9 Other (specify below) Welded
 7 Fiberglass _____ Threaded _____
 Blank casing diameter: 1.6 in. to _____ ft., Dia. _____ in. to _____ ft., Dia. _____ in. to _____ ft.
 Casing height above land surface: 12 in., weight: 188 lbs./ft. Wall thickness or gauge No. _____

TYPE OF SCREEN OR PERFORATION MATERIAL:
 1 Steel 3 Stainless steel 5 Fiberglass 7 PVC 10 Asbestos-cement
 2 Brass 4 Galvanized steel 6 Concrete tile 8 RMP (SR) 11 Other (specify) _____
 12 None used (open hole)

SCREEN OR PERFORATION OPENINGS ARE:
 1 Continuous slot 3 Mill slot 5 Gauzed wrapped 8 Saw cut 11 None (open hole)
 2 Louvered shutter 4 Key punched 6 Wire wrapped 9 Drilled holes
 7 Torch cut 10 Other (specify) Coak Screen

SCREEN-PERFORATED INTERVALS: From 135 ft. to 155 ft. From _____ ft. to _____ ft.
 From 145 ft. to 175 ft. From _____ ft. to _____ ft.
 GRAVEL PACK INTERVALS: From 10 ft. to 175 ft. From _____ ft. to _____ ft.
 From _____ ft. to _____ ft. From _____ ft. to _____ ft.

6 GROUT MATERIAL: 1 Neat cement 2 Cement grout 3 Bentonite 4 Other _____
 Grout Intervals: From 0 ft. to 10 ft. From _____ ft. to _____ ft. From _____ ft. to _____ ft.

What is the nearest source of possible contamination:
 1 Septic tank 4 Lateral lines 7 Pit privy 10 Livestock pens 14 Abandoned water well
 2 Sewer lines 5 Cess pool 8 Sewage lagoon 11 Fuel storage 15 Oil well/Gas well
 3 Watertight sewer lines 6 Seepage pit 9 Feedyard 12 Fertilizer storage 16 Other (specify below) _____
 13 Insecticide storage _____

Direction from well? 100 ft South How many feet? _____

FROM	TO	LITHOLOGIC LOG	FROM	TO	LITHOLOGIC LOG
0	8.5	Top Soil - Clay	01		
8.5	9.5	Clay - Fine Sand	04		
9.5	11.5	S.S.	23		
11.5	13.5	M.B.	23		
13.5	14.5	M Gravel	14		
14.5	15.5	Clay - ss	23		
15.5	17.5	M Gravel	14		
17.5		Debris & Stone	19		

7 CONTRACTOR'S OR LANDOWNER'S CERTIFICATION: This water well was (1) constructed, (2) reconstructed, or (3) plugged under my jurisdiction and was completed on (mo/day/year) 9-20-82 and this record is true to the best of my knowledge and belief. Kansas Water Well Contractor's License No. 214 This Water Well Record was completed on (mo/day/yr) 9-20-82 under the business name of Blue Jay Drilling Co - Inc. by (signature) [Signature]

INSTRUCTIONS: Use typewriter or ball point pen, PLEASE PRESS FIRMLY and PRINT clearly. Please fill in blanks, underline or circle the correct answers. Send top three copies to Kansas Department of Health and Environment, Division of Environment, Environmental Geology Section, Topeka, KS 66620. Send one to WATER WELL OWNER and retain one for your records.

MJP

OFFICE USE ONLY