


1 LOCATION OF WATER WELL: County: Ottawa Fraction NW 1/4 SE 1/4 NW 1/4 Section Number 1 Township Number T 10 S Range Number R 3 EW

Distance and direction from nearest town or city street address of well if located within city?
12 miles North of Bennington Kansas

2 WATER WELL OWNER: Elvin & Rosemary Luth
RR#, St. Address, Box #: 1865 Nugget Rd.
City, State, ZIP Code: Minneapolis, Kansas 67467
Board of Agriculture, Division of Water Resources
Application Number:

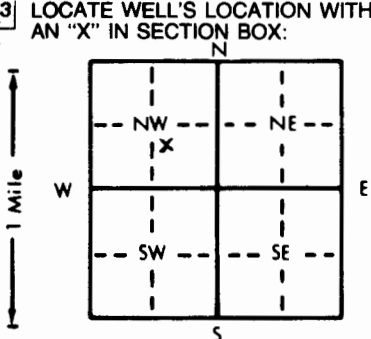

4 DEPTH OF COMPLETED WELL: 999 ft. ELEVATION:
Depth(s) Groundwater Encountered 1.ft. 2.ft. 3.ft.
WELL'S STATIC WATER LEVEL 999 ft. below land surface measured on mo/day/yr
Pump test data: Well water wasft. after hours pumping gpm
Est. Yield gpm: Well water wasft. after hours pumping gpm
Bore Hole Diameterin. toft., andin. toft.
WELL WATER TO BE USED AS:
1 Domestic 3 Feedlot 6 Oil field water supply 9 Dewatering 12 Other (Specify below)
2 Irrigation 4 Industrial 7 Lawn and garden only 10 Monitoring well
Was a chemical/bacteriological sample submitted to Department? Yes.....No.....; If yes, mo/day/yr sample was submitted
Water Well Disinfected? Yes No

5 TYPE OF BLANK CASING USED:
1 Steel 3 RMP (SR) 5 Wrought iron 8 Concrete tile CASING JOINTS: Glued Clamped
2 PVC 4 ABS 6 Asbestos-Cement 9 Other (specify below) Welded
7 Fiberglass Rock Threaded
Blank casing diameter 40 in. toft., Diain. toft., Diain. toft.
Casing height above land surface 60 in., weight lbs./ft. Wall thickness or gauge No.
TYPE OF SCREEN OR PERFORATION MATERIAL:
1 Steel 3 Stainless steel 5 Fiberglass 7 PVC 10 Asbestos-cement
2 Brass 4 Galvanized steel 6 Concrete tile 8 RMP (SR) 11 Other (specify) Rock
9 ABS 12 None used (open hole)
SCREEN OR PERFORATION OPENINGS ARE:
1 Continuous slot 3 Mill slot 5 Gauzed wrapped 8 Saw cut 11 None (open hole)
2 Louvered shutter 4 Key punched 6 Wire wrapped 9 Drilled holes
7 Torch cut 10 Other (specify) Rock
SCREEN-PERFORATED INTERVALS: From NW/999 ft. to 999 ft., Fromft. toft.
Fromft. toft., Fromft. toft.
GRAVEL PACK INTERVALS: Fromft. toft., Fromft. toft.
Fromft. toft., Fromft. toft.

6 GROUT MATERIAL: 1 Neat cement 2 Cement grout 3 Bentonite 4 Other
Grout intervals: From 5.0 ft. to 4.5 ft., Fromft. toft., Fromft. toft.
What is the nearest source of possible contamination:
1 Septic tank 4 Lateral lines 7 Pit privy 10 Livestock pens 14 Abandoned water well
2 Sewer lines 5 Cess pool 8 Sewage lagoon 11 Fuel storage 15 Oil well/Gas well
3 Watertight sewer lines 6 Seepage pit 9 Feedyard 12 Fertilizer storage 16 Other (specify below)
13 Insecticide storage
Direction from well? How many feet?

FROM	TO	LITHOLOGIC LOG	FROM	TO	PLUGGING INTERVALS
			<u>999</u>	<u>5</u>	<u>Clay</u>
			<u>5</u>	<u>4.5</u>	<u>Bentonite</u>
			<u>4.5</u>	<u>0</u>	<u>Clay</u>

7 CONTRACTOR'S OR LANDOWNER'S CERTIFICATION: This water well was (1) constructed, (2) reconstructed, or (3) plugged under my jurisdiction and was completed on (mo/day/year) 10-18-96 and this record is true to the best of my knowledge and belief. Kansas Water Well Contractor's License No. 1500 This Water Well Record was completed on (mo/day/yr) 11-5-96 under the business name of _____ by (signature) Elvin Luth Rosemary Luth

INSTRUCTIONS: Use typewriter or ball point pen. PLEASE PRESS FIRMLY and PRINT clearly. Please fill in blanks, underline or circle the correct answers. Send top three copies to Kansas Department of Health and Environment, Bureau of Water, Topeka, Kansas 66620-0001. Telephone: 913-296-5545. Send one to WATER WELL OWNER and retain one for your records.

OFFICE USE ONLY
T
R
EW
SEC.