


1 LOCATION OF WATER WELL: Fraction Section Number Township Number Range Number
 County: OTTAWA NE 1/4 NW 1/4 NW 1/4 20 T 10 S R 3 E/W

Distance and direction from nearest town or city street address of well if located within city?

2 WATER WELL OWNER: JOHN REYNOLDS
 RR#, St. Address, Box # : 403 E. 1st Board of Agriculture, Division of Water Resources
 City, State, ZIP Code : MINNEAPOLIS, KS. 67467 Application Number:

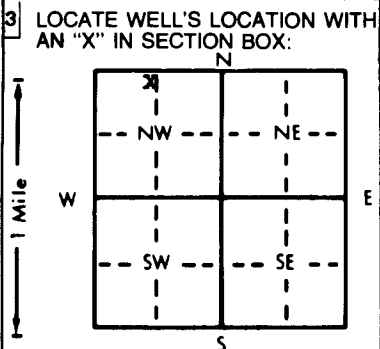

4 DEPTH OF COMPLETED WELL: 68.6 ft. ELEVATION:
 Depth(s) Groundwater Encountered 1. 24.9 ft. 2. ft. 3. ft.
 WELL'S STATIC WATER LEVEL: 24.9 ft. below land surface measured on mo/day/yr 2-22-95
 Pump test data: Well water was 60 ft. after 1 hours pumping 12 gpm
 Est. Yield 12 to 15 gpm: Well water was ft. after hours pumping gpm
 Bore Hole Diameter: 9 in. to 69 ft., and in. to ft.
 WELL WATER TO BE USED AS:
 1 Domestic 3 Feedlot 6 Oil field water supply 9 Dewatering 12 Other (Specify below)
 2 Irrigation 4 Industrial 7 Lawn and garden only 10 Monitoring well
 Was a chemical/bacteriological sample submitted to Department? Yes No X; If yes, mo/day/yr sample was submitted
 Water Well Disinfected? Yes X No

5 TYPE OF BLANK CASING USED:
 1 Steel 3 RMP (SR) 5 Wrought iron 8 Concrete tile CASING JOINTS: Glued X Clamped
 2 PVC 4 ABS 6 Asbestos-Cement 9 Other (specify below) Welded
 7 Fiberglass Threaded
 Blank casing diameter 5 in. to 46.5 ft., Dia. in. to ft., Dia. in. to ft.
 Casing height above land surface 18 in., weight 160 lbs./ft. Wall thickness or gauge No. SDR 26
 TYPE OF SCREEN OR PERFORATION MATERIAL:
 1 Steel 3 Stainless steel 5 Fiberglass 8 RMP (SR) 10 Asbestos-cement
 2 Brass 4 Galvanized steel 6 Concrete tile 9 ABS 11 Other (specify)
 12 None used (open hole)
 SCREEN OR PERFORATION OPENINGS ARE:
 1 Continuous slot 3 Mill slot .035 5 Gauzed wrapped 8 Saw cut 11 None (open hole)
 2 Louvered shutter 4 Key punched 6 Wire wrapped 9 Drilled holes
 7 Torch cut 10 Other (specify)
 SCREEN-PERFORATED INTERVALS: From 46.5 ft. to 68.6 ft., From ft. to ft.
 GRAVEL PACK INTERVALS: From 25 ft. to 68.6 ft., From ft. to ft.

6 GROUT MATERIAL: 1 Neat cement 2 Cement grout 3 Bentonite 4 Other
 Grout intervals: From 0 ft. to 25 ft., From ft. to ft., From ft. to ft.
 What is the nearest source of possible contamination:
 1 Septic tank 4 Lateral lines 7 Pit privy 10 Livestock pens 14 Abandoned water well
 2 Sewer lines 5 Cess pool 8 Sewage lagoon 11 Fuel storage 15 Oil well/Gas well
 3 Watertight sewer lines 6 Seepage pit 9 Feedyard 12 Fertilizer storage 16 Other (specify below)
 13 Insecticide storage OPEN FIELD NONE APPARENT

Direction from well? How many feet?

FROM	TO	LITHOLOGIC LOG	FROM	TO	PLUGGING INTERVALS
0	2	TOP SOIL			
2	34	SANDSTONE REDISH BROWN SOFT			
34	55	CLAY GRAY WITH LAYERS OF SANDSTONE			
55	68.6	CLAY GRAY HARD			

7 CONTRACTOR'S OR LANDOWNER'S CERTIFICATION: This water well was (1) constructed, (2) reconstructed, or (3) plugged under my jurisdiction and was completed on (mo/day/year) 2-22-95 and this record is true to the best of my knowledge and belief. Kansas Water Well Contractor's License No. 388 This Water Well Record was completed on (mo/day/yr) 2-22-95 under the business name of PESTINGER PUMP SERVICE by (signature) [Signature]