WATER WELL RECORD Form WWC-5 KSA 82a-1212 ID No. _____

1 LOCATION OF WATER WELL: County: Sheridan | Fraction: SW ¼ SW ¼ SW ¼ | Section Number: 8 | Township Number: T 10 S | Range Number: R 30 E W

Distance and direction from nearest town or city street address of well if located within city? 1 West of Angelus, Ks

2 WATER WELL OWNER: Don Selensky

RR#, St. Address, Box # : Oakley 1 S, L2748

City, State, ZIP Code :

Board of Agriculture, Division of Water Resources Application Number:

3 LOCATE WELL'S LOCATION WITH AN "X" IN SECTION BOX:

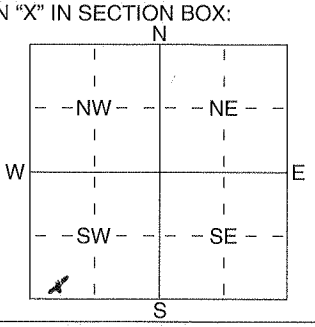


4 DEPTH OF COMPLETED WELL 176 ft. ELEVATION:

Depth(s) Groundwater Encountered 1 126 ft. 2 ft. 3 ft.

WELL'S STATIC WATER LEVEL 126 ft. below land surface measured on mo/day/yr

Pump test data: Well water was ft. after hours pumping gpm

Est. Yield 20 gpm: Well water was ft. after hours pumping gpm

WELL WATER TO BE USED AS: 1 Domestic 2 Irrigation 3 Feedlot 4 Industrial 5 Public water supply 6 Oil field water supply 7 Domestic (lawn & garden) 8 Air conditioning 9 Dewatering 10 Monitoring well 11 Injection well 12 Other (Specify below) Stock

Was a chemical/bacteriological sample submitted to Department? Yes ..... No X; If yes, mo/day/yrs sample was submitted

Water Well Disinfected? (Yes) No

5 TYPE OF BLANK CASING USED: (2) PVC | 1 Steel | 3 RMP (SR) | 4 ABS | 5 Wrought iron | 6 Asbestos-Cement | 7 Fiberglass | 8 Concrete tile | 9 Other (specify below)

CASING JOINTS: Glued X Clamped Welded Threaded

Blank casing diameter 5 in. to 156 ft., Dia in. to ft., Dia in. to ft.

Casing height above land surface 12 in., weight 2.50 lbs./ft. Wall thickness or guage No. 250

TYPE OF SCREEN OR PERFORATION MATERIAL: (7) PVC | 1 Steel | 2 Brass | 3 Stainless Steel | 4 Galvanized Steel | 5 Fiberglass | 6 Concrete tile | 8 RMP (SR) | 9 ABS | 10 Asbestos-Cement | 11 Other (Specify) | 12 None used (open hole)

SCREEN OR PERFORATION OPENINGS ARE: (1) Continuous slot | 2 Louvered shutter | 3 Mill slot | 4 Key punched | 5 Guazed wrapped | 6 Wire wrapped | 7 Torch cut | 8 Saw cut | 9 Drilled holes | 10 Other (specify) | 11 None (open hole)

SCREEN-PERFORATED INTERVALS: From 156 ft. to 176 ft., From ft. to ft.

From ft. to ft., From ft. to ft.

GRAVEL PACK INTERVALS: From 126 ft. to 176 ft., From ft. to ft.

From ft. to ft., From ft. to ft.

6 GROUT MATERIAL: 1 Neat cement 2 Cement grout (3) Bentonite 4 Other

Grout Intervals: From 0 ft. to 20 ft., From ft. to ft., From ft. to ft.

What is the nearest source of possible contamination: (10) Livestock pens | 1 Septic tank | 2 Sewer lines | 3 Watertight sewer lines | 4 Lateral lines | 5 Cess pool | 6 Seepage pit | 7 Pit privy | 8 Sewage lagoon | 9 Feedyard | 11 Fuel storage | 12 Fertilizer storage | 13 Insecticide storage | 14 Abandoned water well | 15 Oil well/Gas well | 16 Other (specify below)

Direction from well? NE How many feet? 100

| FROM | TO | LITHOLOGIC LOG | FROM | TO | PLUGGING INTERVALS |
|---|---|---|---|---|---|
| 0 | 18 | Top soil | | | |
| 18 | 128 | Sandy Clay | | | |
| 128 | 156 | Gravel | | | |
| 156 | 175 | S Clay & St | | | |
| 175 | 176 | Shale | | | |

7 CONTRACTOR'S OR LANDOWNER'S CERTIFICATION: This water well was (1) constructed, (2) reconstructed, or (3) plugged under my jurisdiction and was completed on (mo/day/year) 7-10-13 and this record is true to the best of my knowledge and belief. Kansas Water Well Contractor's Licence No 376 This Water Well Record was completed on (mo/day/yr) 7.10.13 under the business name of B+B Drilling, LLC by (signature) Joseph Berkman

INSTRUCTIONS: Use typewriter or ball point pen. *PLEASE PRESS FIRMLY* and *PRINT* clearly. Please fill in blanks, underline or circle the correct answers. Send top three copies to Kansas Department of Health and Environment, Bureau of Water, Geology Section, 1000 SW Jackson St., Suite 420, Topeka, Kansas 66612-1367. Telephone 785-296-5522. Send one to WATER WELL OWNER and retain one for your records. Fee of $5.00 for each constructed well.