USE TYPEWRITER OR BALL POINT PEN-PRESS FIRMLY, PRINT CLEARLY.

WATER WELL RECORD
KSA 82a-1201-1215

Kansas Department of Health and Environment-Division of Environment
(Water well Contractors)
Topeka, Kansas 66620

1. Location of well:	County	Fraction	Section number	Township number	Range number
	Sheridan	SW 1/4 NE 1/4 Ne 1/4	22	T 10 S	R 30 E/W

2. Distance and direction from nearest town or city: 1W 3N Grinnell Kansas
Street address of well location if in city:

3. Owner of well: William Bixenman
R.R. or street:
City, state, zip code: Grinnell, Kansas

4. Locate with "X" in section below:

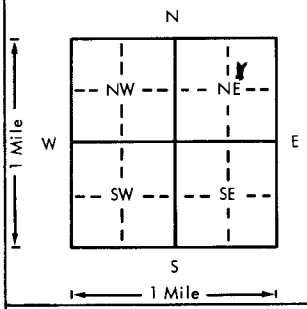

Sketch map:

6. Bore hole dia. 20 in. Completion date 5-26-76
Well depth 112 ft.

7. __ Cable tool __ Rotary __ Driven __ Dug
__ Hollow rod __ Jetted __ Bored X Reverse rotary

8. Use: __ Domestic __ Public supply __ Industry
X Irrigation __ Air conditioning __ Stock
__ Lawn __ Oil field water __ Other

9. Casing: Material Steel Height: Above or below
Threaded ___ Welded ___ Surface 12 in.
RMP ___ PVC ___ Weight ___ lbs./ft.
Dia. ___ in. to ___ ft. depth Wall Thickness: inches or
Dia. 12 3/4 in. to 112 ft. depth gage No. 188

10. Screen: Manufacturer's name W.A.Brown
Type Luver Dia. 12 3/4
Slot/gauze ___ Length ___
Set between 92 ft. and 112 ft.
___ ft. and ___ ft.
Grovel pack? yes Size range of material 1/4 x 5/8

11. Static water level: mo./day/yr.
25 ft. below land surface Date 5-26-76

12. Pumping level below land surfaces:
112 ft. after 5 hrs. pumping 1000 g.p.m.
___ ft. after ___ hrs. pumping ___ g.p.m.
Estimated maximum yield 1000 g.p.m.

13. Water sample submitted: mo./day/yr.
___ Yes X No Date

14. Well head completion:
___ Pitless adapter 12 Inches above grade

15. Well grouted? yes
With: ___ Neat cement X Bentonite ___ Concrete
Depth: From 0 ft. to 10 ft.

16. Nearest source of possible contamination: None
ft. ___ Direction ___ Type ___
Well disinfected upon completion? ___ Yes X No

17. Pump: ___ Not installed
Manufacturer's name Goulds
Model number 12JHC HP 80 Volts ___
Length of drop pipe 100 ft. capacity 1000 g.p.m.
Type:
___ Submersible X Turbine
___ Jet ___ Reciprocating
___ Centrifugal ___ Other

5. Type and color of material	From	To
Top soil	0	20
Fine Sand Med Gravel loose (colored)	20	35
" " Sandy Clay	35	55
" " Med. Gravel Loose (colored)	55	75
" " Sandy Clay	75	85
" " Med Gravel loose (colored)	85	95
" " " " " "	95	109
Ochre Shale (dark)	109	115

(Use a second sheet if needed)

18. Elevation:

Topography:
___ Hill
___ Slope
___ Uplond
X Valley

19. Remarks:

20. Water well contractor's certification:
This well was drilled under my jurisdiction and this report is true to the best of my knowledge and belief.
Business name Blue Jay Drilling Co. Inc. License No. 214
Address Box 503 Colby, Kansas 67701
Signed [signature] Date 7-21-80
Authorized representative

T 10 R 30 E Sec 22 1/4 SW NE 1/4 1/4 1/4

Forward the white, blue and pink copies to the Department of Health and Environment

Form WWC-5

MI-1023