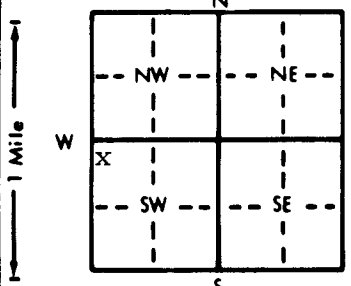


1 LOCATION OF WATER WELL: Fraction NW 1/4 NW 1/4 SW 1/4 Section Number 26 Township Number T 10 S Range Number R 30 W EW
 County: Sheridan
 Distance and direction from nearest town or city street address of well if located within city?
N/A - LOCATION CONFIRMED BY GMD #4

2 WATER WELL OWNER: William H. & Harriett Bixenman
 RR#, St. Address, Box #: Box 192 Board of Agriculture, Division of Water Resources
 City, State, ZIP Code: Grinnell, KS 67738 Application Number:

3 LOCATE WELL'S LOCATION WITH AN "X" IN SECTION BOX:

 4 DEPTH OF COMPLETED WELL: unk. ft. ELEVATION:
 Depth(s) Groundwater Encountered 1. None ft. 2. None ft. 3. None ft.
 WELL'S STATIC WATER LEVEL None ft. below land surface measured on mo/day/yr
 Pump test data: Well water was None ft. after None hours pumping None gpm
 Est. Yield None gpm: Well water was None ft. after None hours pumping None gpm
 Bore Hole Diameter: None in. to None ft., and None in. to None ft.
 WELL WATER TO BE USED AS:
 X1 Domestic 3 Feedlot 6 Oil field water supply 9 Dewatering 12 Other (Specify below)
 2 Irrigation 4 Industrial 7 Lawn and garden only 10 Monitoring well
 Was a chemical/bacteriological sample submitted to Department? Yes.....No.....; If yes, mo/day/yr sample was submitted
 Water Well Disinfected? Yes No

5 TYPE OF BLANK CASING USED:
 X1 Steel 3 RMP (SR) 5 Wrought iron 8 Concrete tile CASING JOINTS: Glued Clamped
 2 PVC 4 ABS 6 Asbestos-Cement 9 Other (specify below) Welded
 7 Fiberglass Threaded.....
 Blank casing diameter 5 in. to None ft., Dia None in. to None ft., Dia None in. to None ft.
 Casing height above land surface 14 in., weight None lbs./ft. Wall thickness or gauge No. None
 TYPE OF SCREEN OR PERFORATION MATERIAL:
 1 Steel 3 Stainless steel 5 Fiberglass 8 RMP (SR) 10 Asbestos-cement
 2 Brass 4 Galvanized steel 6 Concrete tile 9 ABS 12 None used (open hole)
 SCREEN OR PERFORATION OPENINGS ARE:
 1 Continuous slot 3 Mill slot 5 Gauzed wrapped 8 Saw cut 11 None (open hole)
 2 Louvered shutter 4 Key punched 6 Wire wrapped 9 Drilled holes
 7 Torch cut 10 Other (specify)
 SCREEN-PERFORATED INTERVALS: From None ft. to None ft., From None ft. to None ft.
 From None ft. to None ft., From None ft. to None ft.
 GRAVEL PACK INTERVALS: From None ft. to None ft., From None ft. to None ft.
 From None ft. to None ft., From None ft. to None ft.

6 GROUT MATERIAL: 1 Neat cement 2 Cement grout 3 Bentonite 4 Other
 Grout intervals: From None ft. to None ft., From 6 ft. to top ft., From None ft. to None ft.
 What is the nearest source of possible contamination:
 1 Septic tank 4 Lateral lines 7 Pit privy 10 Livestock pens 14 Abandoned water well
 2 Sewer lines 5 Cess pool 8 Sewage lagoon 11 Fuel storage 15 Oil well/Gas well
 3 Watertight sewer lines 6 Seepage pit 9 Feedyard 12 Fertilizer storage 16 Other (specify below)
 13 Insecticide storage
 Direction from well? How many feet?

FROM	TO	LITHOLOGIC LOG	FROM	TO	PLUGGING INTERVALS
		ENTER			
		PLUGGING			
		INFORMATION			
		AT			
		RIGHT			

*Bottom to 6ft clay
6ft to top cement*

RECEIVED
NOV 30 1989
DIVISION OF ENVIRONMENT

7 CONTRACTOR'S OR LANDOWNER'S CERTIFICATION: This water well was (1) constructed, (2) reconstructed, or (3) plugged under my jurisdiction and was completed on (mo/day/year) and this record is true to the best of my knowledge and belief. Kansas
 Water Well Contractor's License No. This Water Well Record was completed on (mo/day/yr) 11-10-89
 under the business name of by (signature) Bill Bixenman

OFFICE USE ONLY T R EW SEC. 1/4 1/4 1/4