


1 LOCATION OF WATER WELL: Fraction SW 1/4 SW 1/4 NW 1/4 Section Number 32S Township Number T 10N S Range Number R 30 EW

Distance and direction from nearest town or city street address of well if located within city?
3 South 1/2 West of Angelus, Kansas

2 WATER WELL OWNER: Harold Baalman Pickerell Drilling
RR#, St. Address, Box #: Box 1303
City, State, ZIP Code: Grinnell, Ks. 67738 Great Bend, Ks. 67530 Board of Agriculture, Division of Water Resources Application Number: T89-013

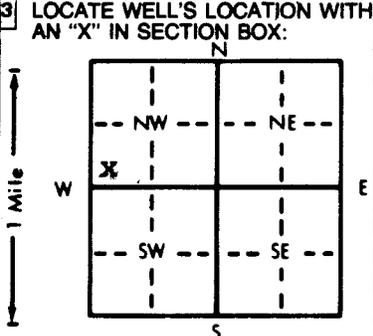

4 DEPTH OF COMPLETED WELL: 210 ft. ELEVATION: ...
Depth(s) Groundwater Encountered 1. ... ft. 2. ... ft. 3. ... ft.
WELL'S STATIC WATER LEVEL: 121 ft. below land surface measured on mo/day/yr 1-10-89
Pump test data: Well water was ... ft. after ... hours pumping ... gpm
Est. Yield ... gpm: Well water was ... ft. after ... hours pumping ... gpm
Bore Hole Diameter: 9 in. to 210 ft., and ... in. to ... ft.
WELL WATER TO BE USED AS:
5 Public water supply 8 Air conditioning 11 Injection well
1 Domestic 3 Feedlot 6 Oil field water supply 9 Dewatering 12 Other (Specify below)
2 Irrigation 4 Industrial 7 Lawn and garden only 10 Monitoring well
Was a chemical/bacteriological sample submitted to Department? Yes.....No...X..... If yes, mo/day/yr sample was submitted
Water Well Disinfected? Yes No X

5 TYPE OF BLANK CASING USED:
1 Steel 3 RMP (SR) 5 Wrought iron 8 Concrete tile CASING JOINTS: Glued .X. Clamped
2 PVC 4 ABS 6 Asbestos-Cement 9 Other (specify below) Welded
7 Fiberglass Threaded
Blank casing diameter: 4.5 in. to 190 ft. Dia. ... in. to ... ft. Dia. ... in. to ... ft.
Casing height above land surface: 18 in., weight 2.38 lbs./ft. Wall thickness or gauge No. 240
TYPE OF SCREEN OR PERFORATION MATERIAL:
1 Steel 3 Stainless steel 5 Fiberglass 8 RMP (SR) 10 Asbestos-cement
2 Brass 4 Galvanized steel 6 Concrete tile 9 ABS 11 Other (specify)
12 None used (open hole)
SCREEN OR PERFORATION OPENINGS ARE:
1 Continuous slot 3 Mill slot 5 Gauzed wrapped 8 Saw cut 11 None (open hole)
2 Louvered shutter 4 Key punched 6 Wire wrapped 9 Drilled holes
7 Torch cut 10 Other (specify)
SCREEN-PERFORATED INTERVALS: From 190 ft. to 210 ft., From ... ft. to ... ft.
GRAVEL PACK INTERVALS: From 20 ft. to 210 ft., From ... ft. to ... ft.

6 GROUT MATERIAL: 1 Neat cement 2 Cement grout 3 Bentonite 4 Other
Grout Intervals: From 0 ft. to 20 ft., From ... ft. to ... ft., From ... ft. to ... ft.
What is the nearest source of possible contamination:
1 Septic tank 4 Lateral lines 7 Pit privy 10 Livestock pens 14 Abandoned water well
2 Sewer lines 5 Cess pool 8 Sewage lagoon 11 Fuel storage 15 Oil well/Gas well
3 Watertight sewer lines 6 Seepage pit 9 Feedyard 12 Fertilizer storage 16 Other (specify below)
13 Insecticide storage
Direction from well? North West How many feet? 1/2 Mile

FROM	TO	LITHOLOGIC LOG	FROM	TO	PLUGGING INTERVALS
0	3	Surface	139	145	Clay
3	42	Clay	145	152	Tight sand
42	49	Sand & Gravel	152	155	Clay
49	73	Clay & Sand streaks	155	157	Sand
73	79	Sand & Gravel	157	163	Clay & caliche
79	95	Sand & Gravel	163	167	Sand
95	105	Med sand & gravel	167	169	Clay
105	110	Clay	169	173	Sand
110	111	Caliche	173	176	Clay
111	120	Clay & caliche	176	183	Sand
120	122	Sand	183	184	Clay
122	131	Caliche & Clay	184	191	Sand
131	137	Sand	191	203	Clay
137	138	Clay	203	207	Med sand
138	139	Sand	207	210	Ochre

7 CONTRACTOR'S OR LANDOWNER'S CERTIFICATION: This water well was (1) constructed, (2) reconstructed, or (3) plugged under my jurisdiction and was completed on (mo/day/year) 1-10-89 and this record is true to the best of my knowledge and belief. Kansas Water Well Contractor's License No. 394 This Water Well Record was completed on (mo/day/yr) 4-18-89 under the business name of Woofter Pump & Well by (signature) [Signature]

OFFICE USE ONLY T R EW SEC. 1/4 1/4 1/4