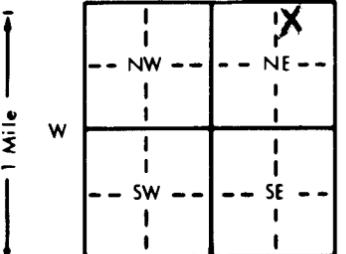


1 LOCATION OF WATER WELL:		Fraction		Section Number		Township Number		Range Number	
County: Thomas		NW 1/4 NE 1/4 NE 1/4		21		T 10 S		R 31 EW	
Distance and direction from nearest town or city street address of well if located within city? 4 north 4 east 1 south 3/4 east of Oakley, Ks.									
2 WATER WELL OWNER: L. Ottley #1				Murfin Drilling			Board of Agriculture, Division of Water Resources		
RR#, St. Address, Box # :				Box 661			Application Number: 900297		
City, State, ZIP Code :				Colby, Ks. 67740					
3 LOCATE WELL'S LOCATION WITH AN "X" IN SECTION BOX:				4 DEPTH OF COMPLETED WELL: 146 ft. ELEVATION:					
				Depth(s) Groundwater Encountered 1. ft. 2. ft. 3. ft. WELL'S STATIC WATER LEVEL 94 ft. below land surface measured on mo/day/yr Pump test data: Well water was ft. after hours pumping gpm Est. Yield gpm: Well water was ft. after hours pumping gpm Bore Hole Diameter 8 in. to 146 ft., and in. to ft. WELL WATER TO BE USED AS: 1 Domestic 3 Feedlot 6 Oil field water supply 9 Dewatering 12 Other (Specify below) 2 Irrigation 4 Industrial 7 Lawn and garden only 10 Monitoring well Was a chemical/bacteriological sample submitted to Department? Yes No X; If yes, mo/day/yr sample was submitted Water Well Disinfected? Yes No X					
5 TYPE OF BLANK CASING USED:									
1 Steel 3 RMP (SR) 5 Wrought iron 8 Concrete tile CASING JOINTS: Glued X Clamped									
2 PVC 4 ABS 6 Asbestos-Cement 9 Other (specify below) Welded									
7 Fiberglass Threaded									
Blank casing diameter 4.5 in. to 106 ft., Dia in. to ft., Dia in. to ft.									
Casing height above land surface 36 in., weight 2.38 lbs./ft. Wall thickness or gauge No. 248									
TYPE OF SCREEN OR PERFORATION MATERIAL:									
1 Steel 3 Stainless steel 5 Fiberglass 8 RMP (SR) 11 Other (specify)									
2 Brass 4 Galvanized steel 6 Concrete tile 9 ABS 12 None used (open hole)									
SCREEN OR PERFORATION OPENINGS ARE:									
1 Continuous slot 3 Mill slot 5 Gauzed wrapped 8 Saw cut 11 None (open hole)									
2 Louvered shutter 4 Key punched 6 Wire wrapped 9 Drilled holes									
7 Torch cut 10 Other (specify)									
SCREEN-PERFORATED INTERVALS: From ft. to ft., From ft. to ft., From ft. to ft.									
GRAVEL PACK INTERVALS: From ft. to ft., From ft. to ft., From ft. to ft.									
6 GROUT MATERIAL:									
1 Neat cement 2 Cement grout 3 Bentonite 4 Other									
Grout Intervals: From ft. to ft., From ft. to ft., From ft. to ft.									
What is the nearest source of possible contamination:									
1 Septic tank 4 Lateral lines 7 Pit privy 10 Livestock pens 14 Abandoned water well									
2 Sewer lines 5 Cess pool 8 Sewage lagoon 11 Fuel storage 15 Oil well/Gas well									
3 Watertight sewer lines 6 Seepage pit 9 Feedyard 12 Fertilizer storage 16 Other (specify below)									
13 Insecticide storage 50									
Direction from well? NW How many feet?									
FROM TO		LITHOLOGIC LOG		FROM TO		PLUGGING INTERVALS			
				146 96		Washed sand			
				96 6		Clay			
				6 3		Hole plug			
				3 0		Surface			
7 CONTRACTOR'S OR LANDOWNER'S CERTIFICATION: This water well was (1) constructed, (2) reconstructed, or (3) plugged under my jurisdiction and was completed on (mo/day/year) 8-22-90 and this record is true to the best of my knowledge and belief. Kansas Water Well Contractor's License No. 394 This Water Well Record was completed on (mo/day/yr) 8-23-90 under the business name of WOOFER PUMP & WELL by (signature) [Signature]									
INSTRUCTIONS: Use typewriter or ball point pen. PLEASE PRESS FIRMLY and PRINT clearly. Please fill in blanks, underline or circle the correct answers. Send top three copies to Kansas Department of Health and Environment, Bureau of Water, Topeka, Kansas 66620-7320. Telephone: 913-296-5545. Send one to WATER WELL OWNER and retain one for your records.									